

March 19, 2020

TECO Peoples Gas
James K. Hamilton
8416 Palm River Road
Tampa, Florida 33619

ADJUSTMENT OF UTILITIES-STATE STATUTE CHAPTER 337.403

Project Road: East Twiggs Street
County: Hillsborough
THEA Project ID: 0-00419
Description: East Twiggs Street from West of N. Nebraska Avenue to West of N. Meridian Avenue. – Design-Build Widening Project

Dear Mr. Hamilton:

For the above referenced project, WGI is under contract with the Tampa Hillsborough Expressway Authority to coordinate relocations and/or adjustments of your facilities. Please address all correspondence concerning all coordination, both verbal and written, to WGI, Chris Stermer, Utility Coordination Manager. Please send all correspondence to the address below.

The enclosed Utility Work Schedule has been approved by Tampa-Hillsborough Expressway Authority (THEA). THEA anticipates letting the Design-Build Project in Fall 2020. THEA is requesting that all possible relocations for the project be completed prior to the Design Build Contracts award. Therefore, all UAO work for this project must be completed by **September 1, 2020**. You are advised to proceed with your utility work as depicted in the approved Utility Work Schedule (UWS).

Prior to the commencement of your work, you must obtain all required Utility Permits. To expedite your permit review time, please include your executed UWS with all permit applications.

Any changes, revisions, deletions, or additions to the approved Utility Work Schedule must be documented and approved by the THEA. Upon completion of construction, as-built plans must be provided to this office.

A Pre-Construction meeting has been scheduled for **3:00 PM on April 9, 2020** via WebEx. An Outlook meeting invite will be sent to include a WebEx link. If you are not able to call-in, please have a knowledgeable representative call-in in your absence.

Thank you for your cooperation. Should you have any questions don't hesitate to contact me directly at 813-559-2262, or by email at Chris.Stermer@WGInc.com.

Sincerely,
Chris Stermer
Utility Coordination Manager



Enclosures

cc: David May, PE, THEA Director of Expressway Operations
Judith Villegas, EI, THEA, Project Manager
James E. Drapp, PE, VP, HNTB, Project Manager
Alphonse Stewart, PE, HNTB, Project Manager
Megan Tetro, PE, WGI, EOR, Project Manager

File

TAMPA HILLSBOROUGH
EXPRESSWAY AUTHORITY

CONTRACT PLANS



INDEX OF ROADWAY PLANS	
SHEET NO.	SHEET DESCRIPTION
1	KEY SHEET
2	SIGNATURE SHEET
3	GENERAL NOTES
UTV-1	SUMMARY OF VERIFIED UTILITIES
4 - 5	UTILITY ADJUSTMENT TYPICAL SECTION* ROADWAY PLAN*

* PLAN SHEETS PROVIDED FOR INFORMATION ONLY

PROJECT ID: O-00419

HILLSBOROUGH COUNTY (10002)

E. TWIGGS STREET UTILITY ADJUSTMENTS

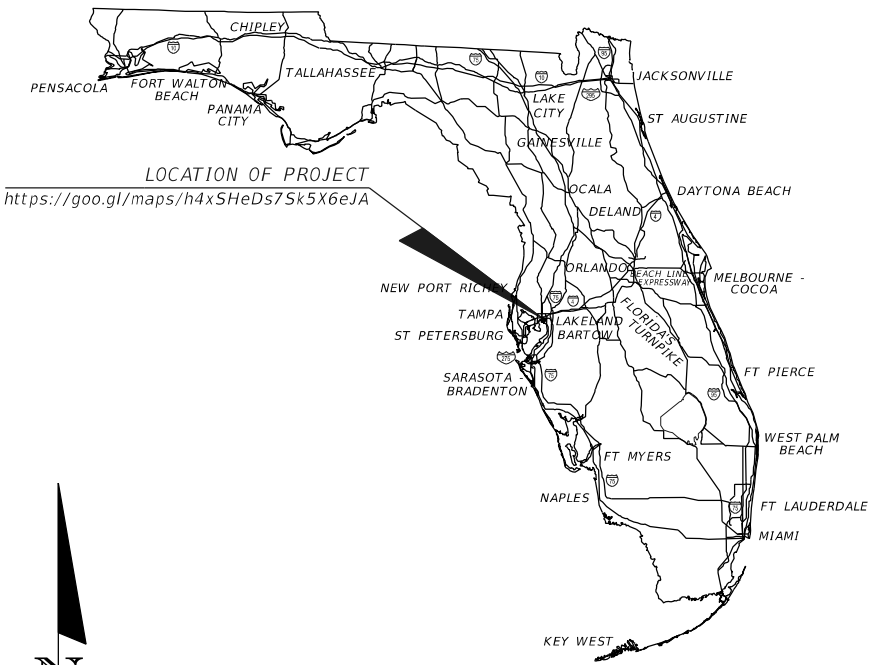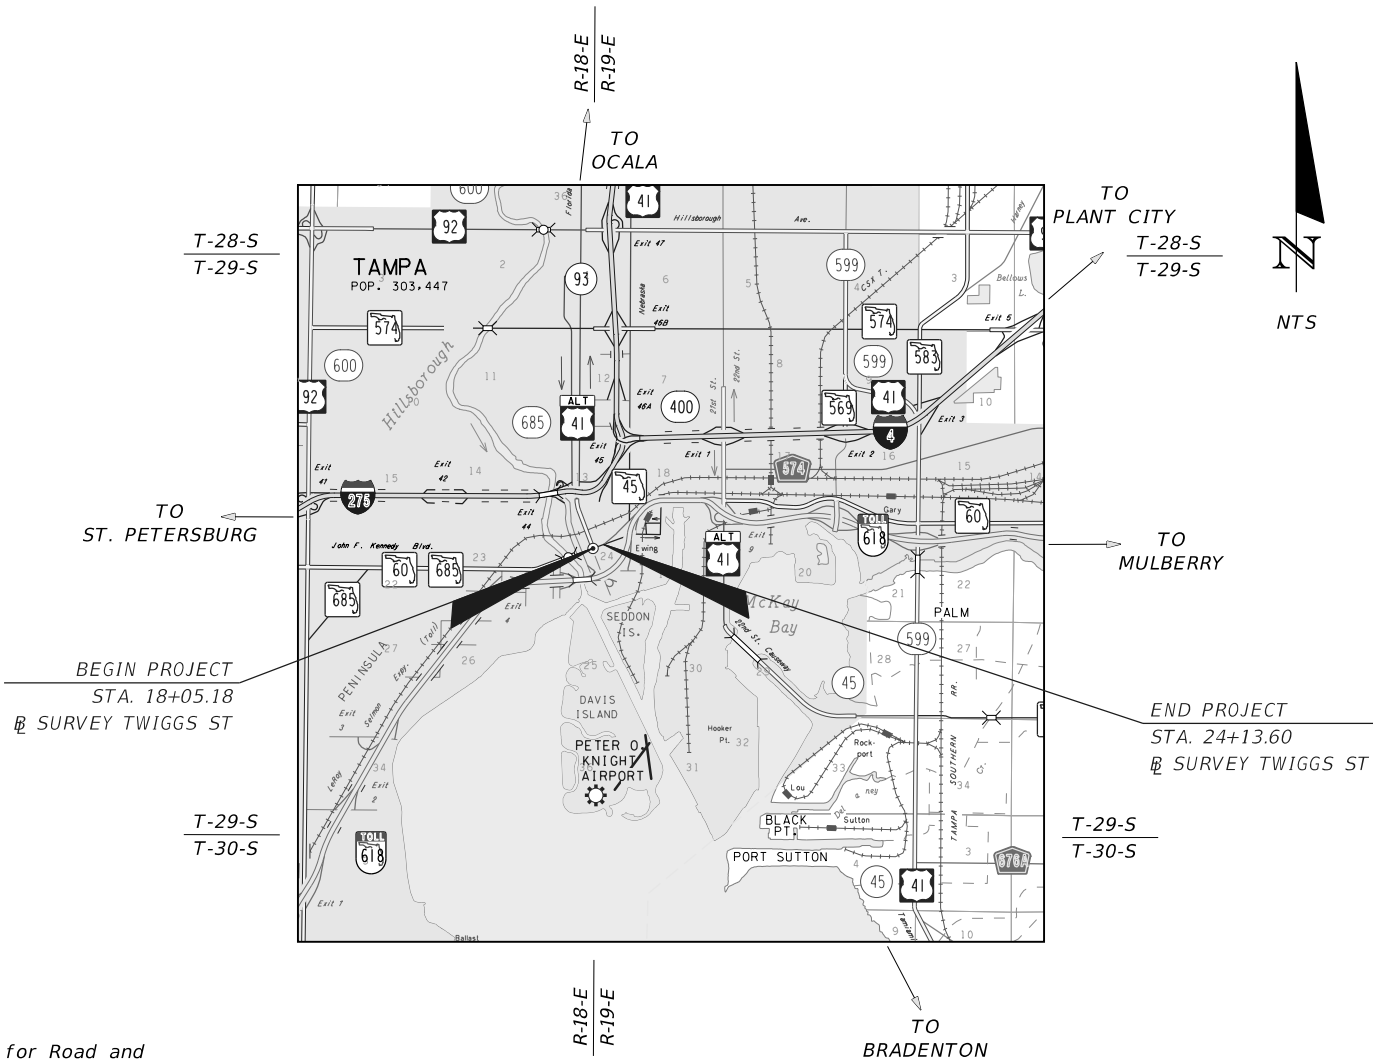

GOVERNING STANDARD PLANS:
Florida Department of Transportation, FY2018/19 Standard Plans for Road and Bridge Construction and applicable Interim Revisions (IRs).

Standard Plans for Road Construction and associated IRs are available at the following website: <http://www.fdot.gov/design/standardplans>

GOVERNING STANDARD SPECIFICATIONS:
Florida Department of Transportation, July 2018 Standard Specifications for Road and Bridge Construction at the following website: <http://www.fdot.gov/programmanagement/Implemented/SpecBooks>

TECO PGS RGB
MARKED PLANS
AUGUST 30, 2019




**ROADWAY PLANS
ENGINEER OF RECORD:**

MEGAN M. TETRO, P.E. NO.: 76120
WANTMAN GROUP, INC.
3111 W. DR. MARTIN LUTHER KING JR. BLVD.,
SUITE 375, TAMPA, FL 33607
(813) 574-3190
CERTIFICATE OF AUTHORIZATION NO.: 6091


THEA PROJECT MANAGER:
DAVID MAY, P.E.

CONSTRUCTION CONTRACT NO.	FISCAL YEAR	SHEET NO.
		1

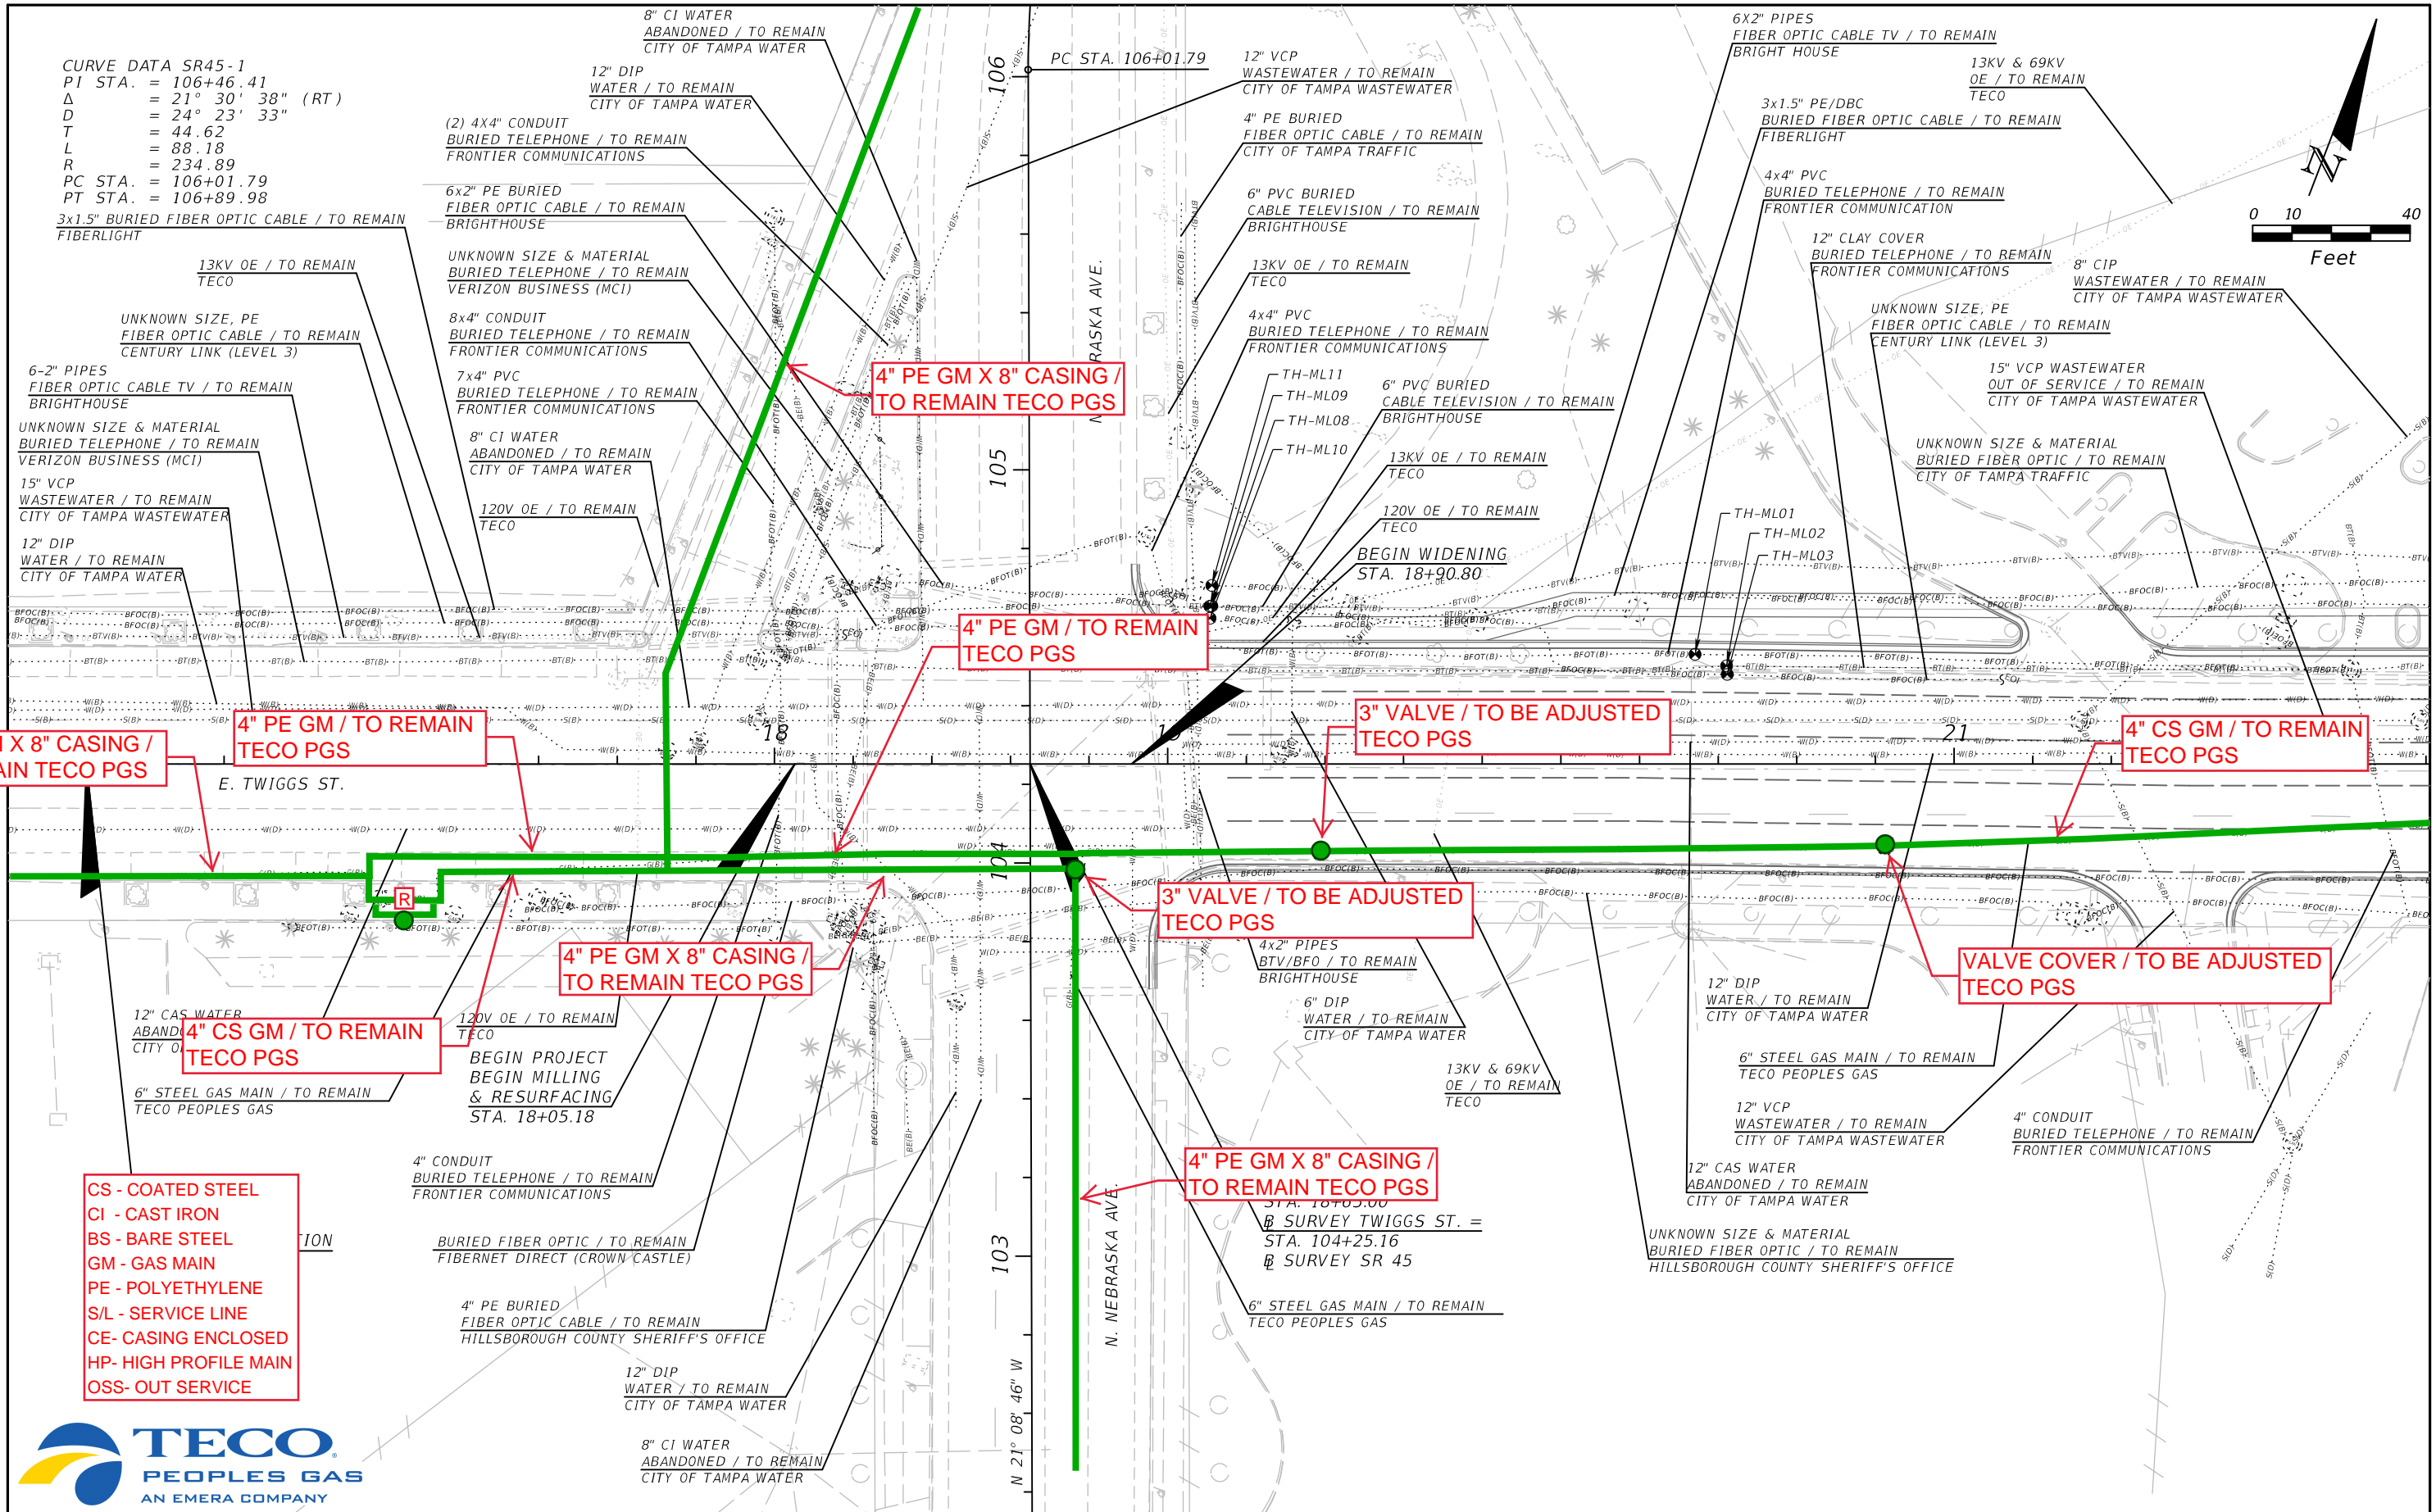

REVISIONS				MEGAN M. TETRO, P.E. FLORIDA PE NO. 76120 WANTMAN GROUP, INC. 3111 W. MARTIN LUTHER KING JR. BLVD., SUITE 375, TAMPA, FL 33607 CERTIFICATE OF AUTHORIZATION NO. 6091	TAMPA HILLSBOROUGH EXPRESSWAY AUTHORITY			UTILITY ADJUSTMENT (1)	SHEET NO. 4
DATE	DESCRIPTION	DATE	DESCRIPTION		ROAD	COUNTY	CONTRACT NO.		
					TWIGGS	HILLSBOROUGH	000419		

THE OFFICIAL RECORD OF THIS SHEET IS THE ELECTRONIC FILE DIGITALLY SIGNED AND SEALED UNDER RULE 61G15-23.004, F.A.C.

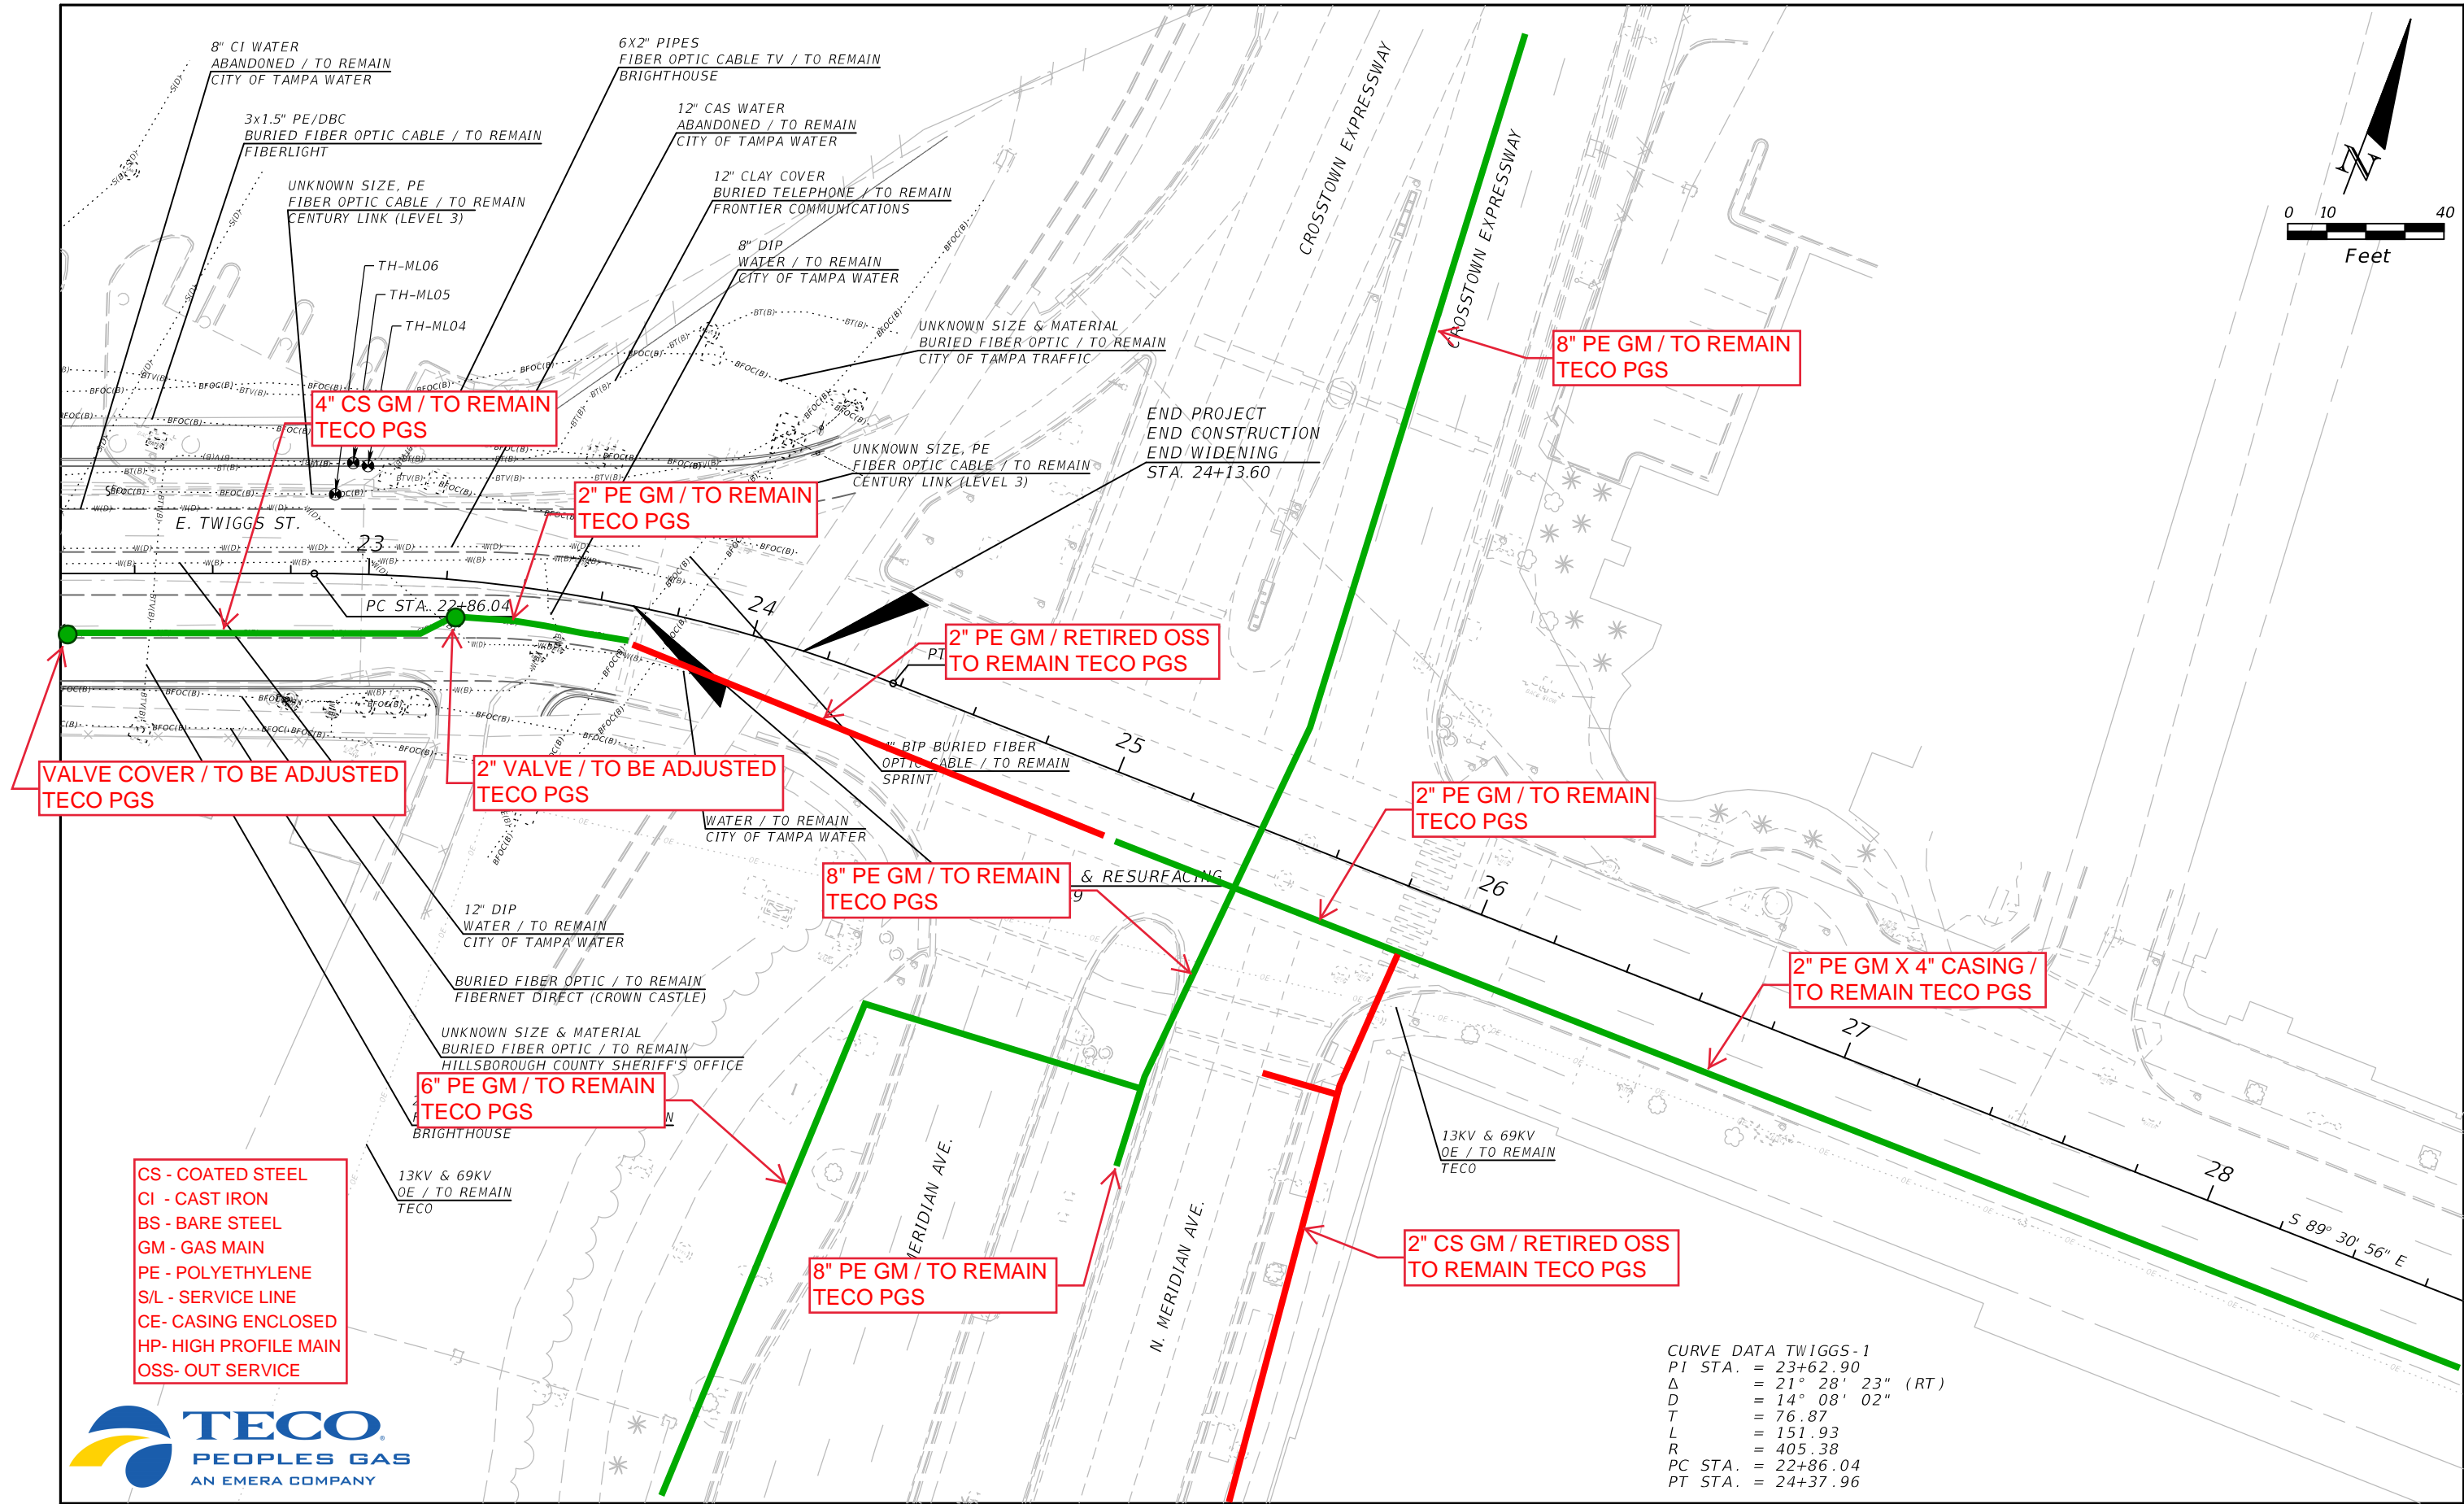

REVISIONS			
DATE	DESCRIPTION	DATE	DESCRIPTION

MEGAN M. TETRO, P.E.
FLORIDA PE NO. 76120
WANTMAN GROUP, INC.
3111 W. MARTIN LUTHER KING JR. BLVD.,
SUITE 375, TAMPA, FL 33607
CERTIFICATE OF AUTHORIZATION NO. 6091

TAMPA HILLSBOROUGH EXPRESSWAY AUTHORITY		
ROAD	COUNTY	CONTRACT NO.
TWIGGS	HILLSBOROUGH	000419

UTILITY ADJUSTMENT (2)	

SHEET NO.
5

THE OFFICIAL RECORD OF THIS SHEET IS THE ELECTRONIC FILE DIGITALLY SIGNED AND SEALED UNDER RULE 61G15-23.004, F.A.C.

FLORIDA DEPARTMENT OF TRANSPORTATION
UTILITY WORK SCHEDULE

December 14, 2016

Pursuant to Section 337.403 F.S., the UAO and FDOT agree to the UAO's need for relocation or adjustment to its utilities and FDOT's need for a schedule for the UAO to effect the relocation or adjustment. This utility work schedule is based on FDOT plans dated in the project information box below. Any deviation by FDOT or its contractor from these plans, may void this utility work schedule. Upon notification by FDOT of a change to these plans, the UAO may negotiate a new utility work schedule. The UAO agrees to notify FDOT and the contractor in writing prior to starting, stopping, resuming, and completing work in accordance with this utility work schedule. The UAO shall obtain a utility permit and comply with requirements of the 2017 Utility Accommodation Manual (UAM) for all work done under this utility work schedule. The UAO is not responsible for events beyond the control of the UAO that could not be reasonably anticipated by the UAO and which could not be avoided by the UAO with exercise of due diligence at the time of the occurrence.

FDOT PROJECT INFORMATION

Financial Project ID: O-00419	Federal Project ID:
State Road Number: N/A	County: Hillsborough
FDOT Plans Dated: July 2019	District Document No.: N/A

UTILITY AGENCY/OWNER (UAO)

Utility Company: TECO PEOPLES GAS			
UAO Project Rep: JAMES HAMILTON	Phone: 813-275-3732	E-mail: JKHAMILTON@TECOENERGY.COM	
UAO Field Rep: MARK BYRD	Phone: 813-275-3788	E-mail: MABYRD@TECOENERGY.COM	

UTILITY SIGNATURE

I have reviewed the FDOT plans referenced above and submit this utility work schedule in compliance with UAM Section 5 and agree to be bound by the terms of this utility work schedule.

UAO Rep.  Digitally signed by James Hamilton
Date: 2019.08.30 14:41:53 -04'00'
Name JAMES HAMILTON
Title GAS DESIGN TECHNICIAN II

Date 8 / 30 / 2019

ENGINEER OF RECORD SIGNATURE

I attest this utility work schedule is compatible with the FDOT plans referenced above.

EOR. Megan Tetro Digitally signed by Megan Tetro
Date: 2020.02.19 15:59:26 -05'00'
Name Megan M. Tetro, P.E.
Title Engineer of Record

Date / /

APPROVAL BY DISTRICT UTILITIES

This utility work schedule is complete and acceptable to FDOT.

FDOT Rep. David May
Name David May
Title Director of Operations

Date 03/10/2020
 / /

SECTION A: SUMMARY OF UTILITY WORK

The below days are the total numbers of days shown for all activities in Section C of this utility work schedule. The breakdown of how these days are to be incorporated into the FDOT project and the dependence of these days upon the completion of other activities by the UAO or others is shown in Section C.

Days prior to FDOT project construction:

Days during FDOT project construction: 5

FLORIDA DEPARTMENT OF TRANSPORTATION
UTILITY WORK SCHEDULE

December 14, 2016

Financial Project ID: O-00419
Utility Company: TECO PEOPLES GAS
FDOT Plans Dated: July 2019

SECTION B: UAO SPECIAL CONDITIONS/CONSTRAINTS

1. THE TECO PEOPLES GAS 24-HOUR EMERGENCY NUMBER 1-877 TECO PGS (1-877-832-6747).
2. TECO PEOPLES GAS CREW AVAILABILITY MAY BE AFFECTED OR LIMITED DUE TO OUR REQUIRED RESPONSE TO EMERGENCY CONDITIONS ELSEWHERE. THIS LIMITATION WILL BE DEPENDENT UPON THE SEVERITY AND LOCATION OF THE EMERGENCY.
3. TECO PEOPLES GAS SUBCONTRACTORS NORMAL WORK SCHEDULE IS MONDAY THROUGH FRIDAY FROM 8 A.M. TO 5 P.M., EXCLUDING TECO PEOPLES GAS OBSERVED HOLIDAY'S (NEW YEARS DAY, GOOD FRIDAY, MEMORIAL DAY, JULY 4TH, LABOR DAY, THANKSGIVING DAY, THE FRIDAY AFTER THANKSGIVING DAY, CHRISTMAS EVE DAY AND CHRISTMAS DAY). ANY TECO PEOPLES GAS ASSISTANCE REQUESTED FROM THE FDOT, THEIR CONTRACTOR OR SUBCONTRACTOR OUTSIDE OF THESE NORMAL WORKING HOURS MUST BE SCHEDULED 48 HOURS IN ADVANCE. TECO PEOPLES GAS REQUIRES VERIFICATION THAT THE CREWS ARE STILL NEEDED ON THE ACTUAL WORKDAY (MONDAY THROUGH FRIDAY) THAT HAD PREVIOUSLY BEEN REQUESTED OR THE LAST BUSINESS DAY BEFORE THE REQUESTED WEEKEND OR HOLIDAY.
4. A COPY OF THE APPROVED CONTRACTOR'S CPM (CRITICAL PATH METHOD) IS REQUESTED WITHIN 5 DAYS OF APPROVAL.

FLORIDA DEPARTMENT OF TRANSPORTATION
UTILITY WORK SCHEDULE

December 14, 2016

Financial Project ID: O-00419
Utility Company: TECO PEOPLES GAS
FDOT Plans Dated: July 2019

SECTION C: UAO's WORK ACTIVITIES

Act. No.	Utility Facility (type, size, material, status)	From Station/ Offset	To Station/ Offset	Utility Work Activity Description	Dependent Activity	TCP Phase	Consecutive Calendar Days	
							Prior to Const.	During Const.
1	VALVE COVER	STA. 18+76, 26.6' RT	STA. 18+76, 26.6' RT	TO BE ADJUSTED TO FINAL GRADE	FINAL GRADE ESTABLISHED	N/A		1
2	VALVE COVER	STA. 19+39, 26.6' RT	STA. 19+39, 26.6' RT	TO BE ADJUSTED TO FINAL GRADE	FINAL GRADE ESTABLISHED	N/A		1
3	VALVE COVER	STA. 20+82, 20.8' RT	STA. 20+82, 20.8' RT	TO BE ADJUSTED TO FINAL GRADE	FINAL GRADE ESTABLISHED	N/A		1
4	VALVE COVER	STA. 22+20, 15.2' RT	STA. 22+20, 15.2' RT	TO BE ADJUSTED TO FINAL GRADE	FINAL GRADE ESTABLISHED	N/A		1
5	VALVE COVER	STA. 23+23, 9.5' RT	STA. 23+23, 9.5' RT	TO BE ADJUSTED TO FINAL GRADE	FINAL GRADE ESTABLISHED	N/A		1