



DRAWING ACCURACY  
 WAS NOT VERIFIED.  
 FIELD VERIFY LOCATIONS  
 AND DEPTHS.

UHWCA	FINANCIAL PROJECT ID	STATE PROJ. NO.	SHEET NO.
255853-1-56-01			U - 7

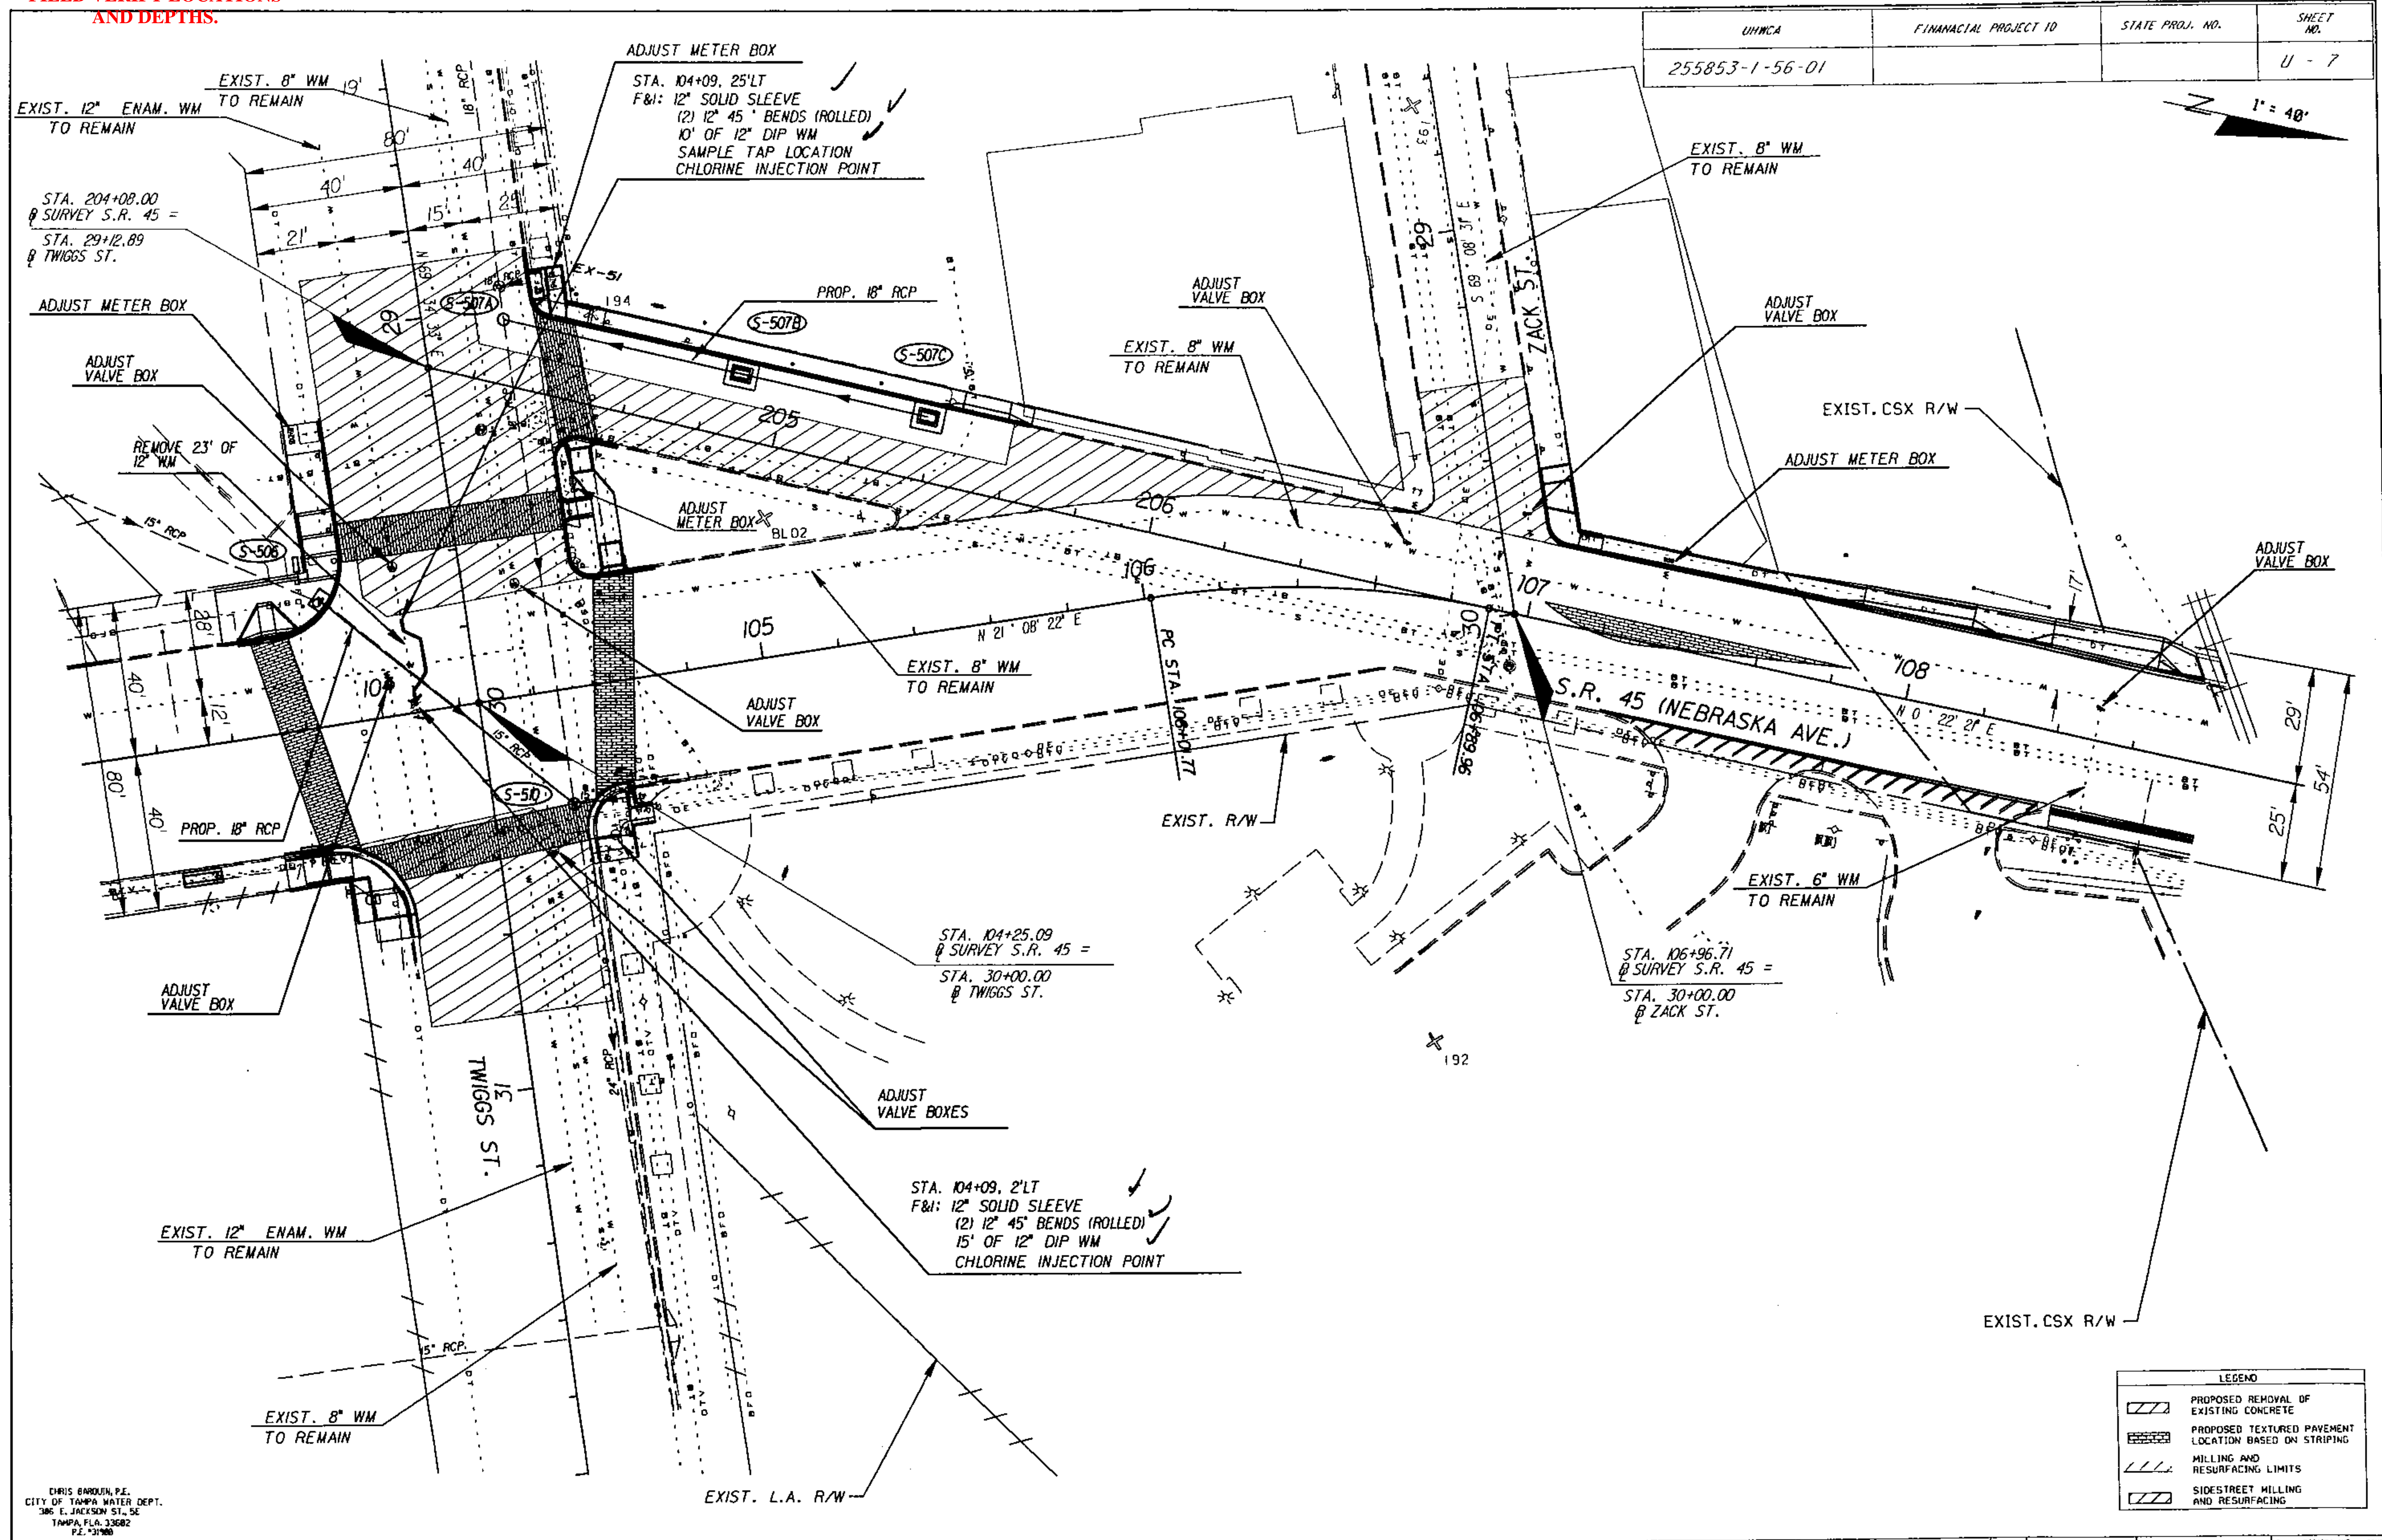

LEGEND	
	PROPOSED REMOVAL OF EXISTING CONCRETE
	PROPOSED TEXTURED PAVEMENT LOCATION BASED ON STRIPING
	MILLING AND RESURFACING LIMITS
	SIDESTREET MILLING AND RESURFACING

CHRIS BARDEN, P.E.  
 CITY OF TAMPA WATER DEPT.  
 386 E. JACKSON ST., SE  
 TAMPA, FLA. 33602  
 P.2. 51788

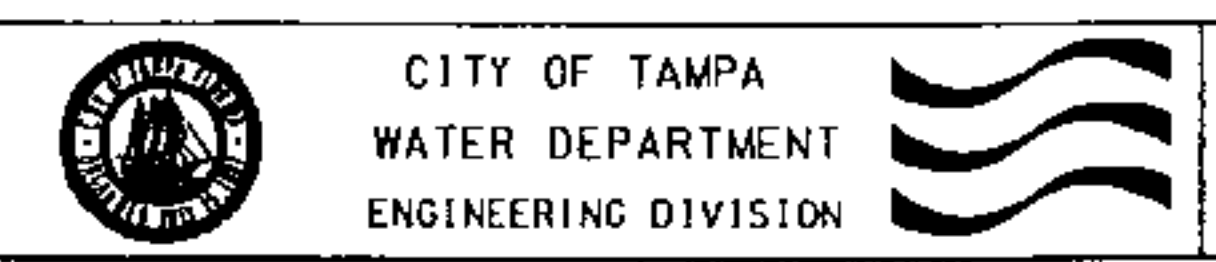

MAIN RELOCATION

S.R. 45 FROM KENNEDY BLVD. TO HILLSBOROUGH AVE.  
 STA. 103+20 TO STA. 108+80

40	0	40	1" = 40' HORIZ.
2	0	2	1" = 2' VERT.

Atlas Pages	No.	Date	REVISION	By
H-12				
J-13				

Des: CB	W.D. 4540	File: NEBRASKA AVE. - SOUTH
Draw: FJ		
Ckd: CB		
SHEET 7 OF 55 SHEETS		

FC84-175-7

NOTICE: THE OFFICIAL RECORD OF THIS PLAN SHEET IS THE ELECTRONIC FILE STORED AND SEALED UNDER RULE 61G15-23.003, F.A.C.