

6" ISOLATION VALVE NWC OF JEFFERSON STREET AND ZACK STREET (SEE WATER MAIN ATLAS H-12)

EXISTING 6" CIP WATER MAIN (TO REMAIN IN SERVICE)  
EXISTING F.H. AND VALVE BOX (REMOVED)

# NEBRASKA AVENUE (S.R. 45)

EXISTING 10" CIP WATER MAIN (PLACED OUT OF SERVICE AND GROUTED)

SEC. 19-T29S-R18E

STA. 55+39.0, 20.0' LT.  
1-12" GATE VALVE W/BOX (TON 17.59)

STA. 55+43.0, 20.0' LT.  
1-12" SOLID SLEEVE

12" WATER MAIN (SEE W.O. 7040)

STA. 56+45.0, 20.0' LT.  
1-12"x12" MJ TEE

**DRAWING ACCURACY WAS NOT VERIFIED. FIELD VERIFY LOCATIONS AND DEPTHS.**

STA. 55+36.5, 20.0' LT.  
1-12"x6" ANCHOR TEE  
1-6" GATE VALVE W/BOX (TON 15.50)  
4-6" 45° BENDS,  
1-6" SOLID SLEEVE  
21 LF OF 6" DIP WATER MAIN (POLYWRAPPED) CONNECTED TO EXISTING WATER MAIN

72 LF OF 20" STEEL CASING PIPE BY JACK AND BORE

CUT AND CAP FOR GROUTING

THROAT EL. 19.40  
(S) EL. 15.40  
(W) EL. 15.68

EXISTING 8" CIP WATER MAIN (TO BE PLACED OUT OF SERVICE AND GROUTED IN W.O. 7041-A)

PROPOSED 12" WATER MAIN (SEE W.O. 7041-A)

VALVE BOX GROUTED IN PLACE  
EXISTING 8" CIP WATER MAIN (PLACED OUT OF SERVICE AND GROUTED)

VALVE BOX GROUTED IN PLACE

SEE NOTE 2

PROPOSED 12" WATER MAIN (W.O. 5941)

8" ISOLATION VALVE SWC OF NEBRASKA AVENUE AND HARRISON STREET (SEE WATER MAIN ATLAS H-12)

MATCHLINE STA. 53+50.0 SEE SHT 74 FOR CONTINUATION

STA. 53+67.0, 31.0' LT.  
1-12"x6" ANCHOR TEE  
1-6" GATE VALVE W/BOX (TON 17.63)  
1-1 1/4" BEND  
1-2 1/2" BEND  
1-5/8" DNS FIRE HYDRANT METHOD 1

STA. 54+06.0, 18.0' LT.  
1-12"x6" ANCHOR TEE  
1-6" GATE VALVE W/BOX (TON 17.59)  
1-6" 45° BEND  
2-6" 22 1/2° BEND  
RESTRAIN ALL PIPE JOINTS ON EXISTING WATER MAIN WITHIN 20' LF OF THE PROPOSED 6" 22 1/2° BEND  
1-6" SOLID SLEEVE  
33 LF OF 6" DIP WATER MAIN (POLYWRAPPED) CONNECTED TO EXISTING WATER MAIN

320 LF OF 12" DIP WATER MAIN (POLYWRAPPED)

## RECORD DRAWING LEGEND


## PLAN

## RECORD DRAWING

THIS RECORD DRAWING IS NOT WARRANTED BUT IS BELIEVED TO REPRESENT CONDITIONS UPON COMPLETION OF CONSTRUCTION WITHIN REASONABLE TOLERANCES, BASED UPON THE INFORMATION FURNISHED TO THE ENGINEER FROM THE CONTRACTOR PERTAINING TO CHANGES MADE DURING CONSTRUCTION. STRIKE THROUGH OF THE ORIGINAL DESIGN/CALL-OUTS WERE NOT USED. SEE RECORD DRAWING LEGEND ON THIS SHEET.



**GREELEY AND HANSEN**  
1715 N. WESTSHORE BLVD., STE. 464  
TAMPA, FLORIDA 33607  
CERTIFICATE OF AUTHORIZATION NO. 37

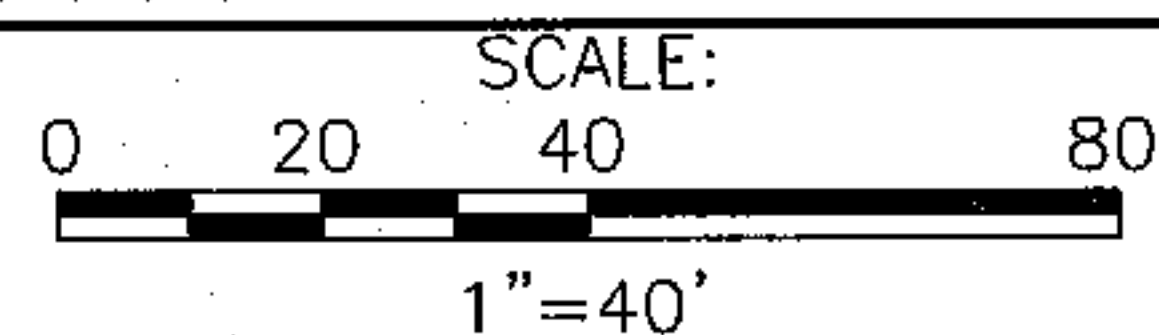

DESIGNED NAM, ML  
DRAWN GAG  
CHECKED TYW

NO.	DATE	APPD	REVISION
07/11	TYW		RECORD DRAWING REVISIONS
P.E. NAME: THOMAS Y. WILSON		P.E. NO. 40284	
P.E. NAME:			
DATE:			

CITY OF TAMPA WATER DEPARTMENT  
2008 WATER MAIN IMPROVEMENTS - DOWNTOWN PHASE C  
PLAN  
NEBRASKA AVENUE  
STA. 53+50.0 TO STA. 56+45.0

W.O. NO. 7042  
FILE: DTCTESH04  
NO. 76 OF 134  
DATE JULY 2011

FC84-437