


**DRAWING ACCURACY  
WAS NOT VERIFIED.  
FIELD VERIFY LOCATIONS  
AND DEPTHS.**

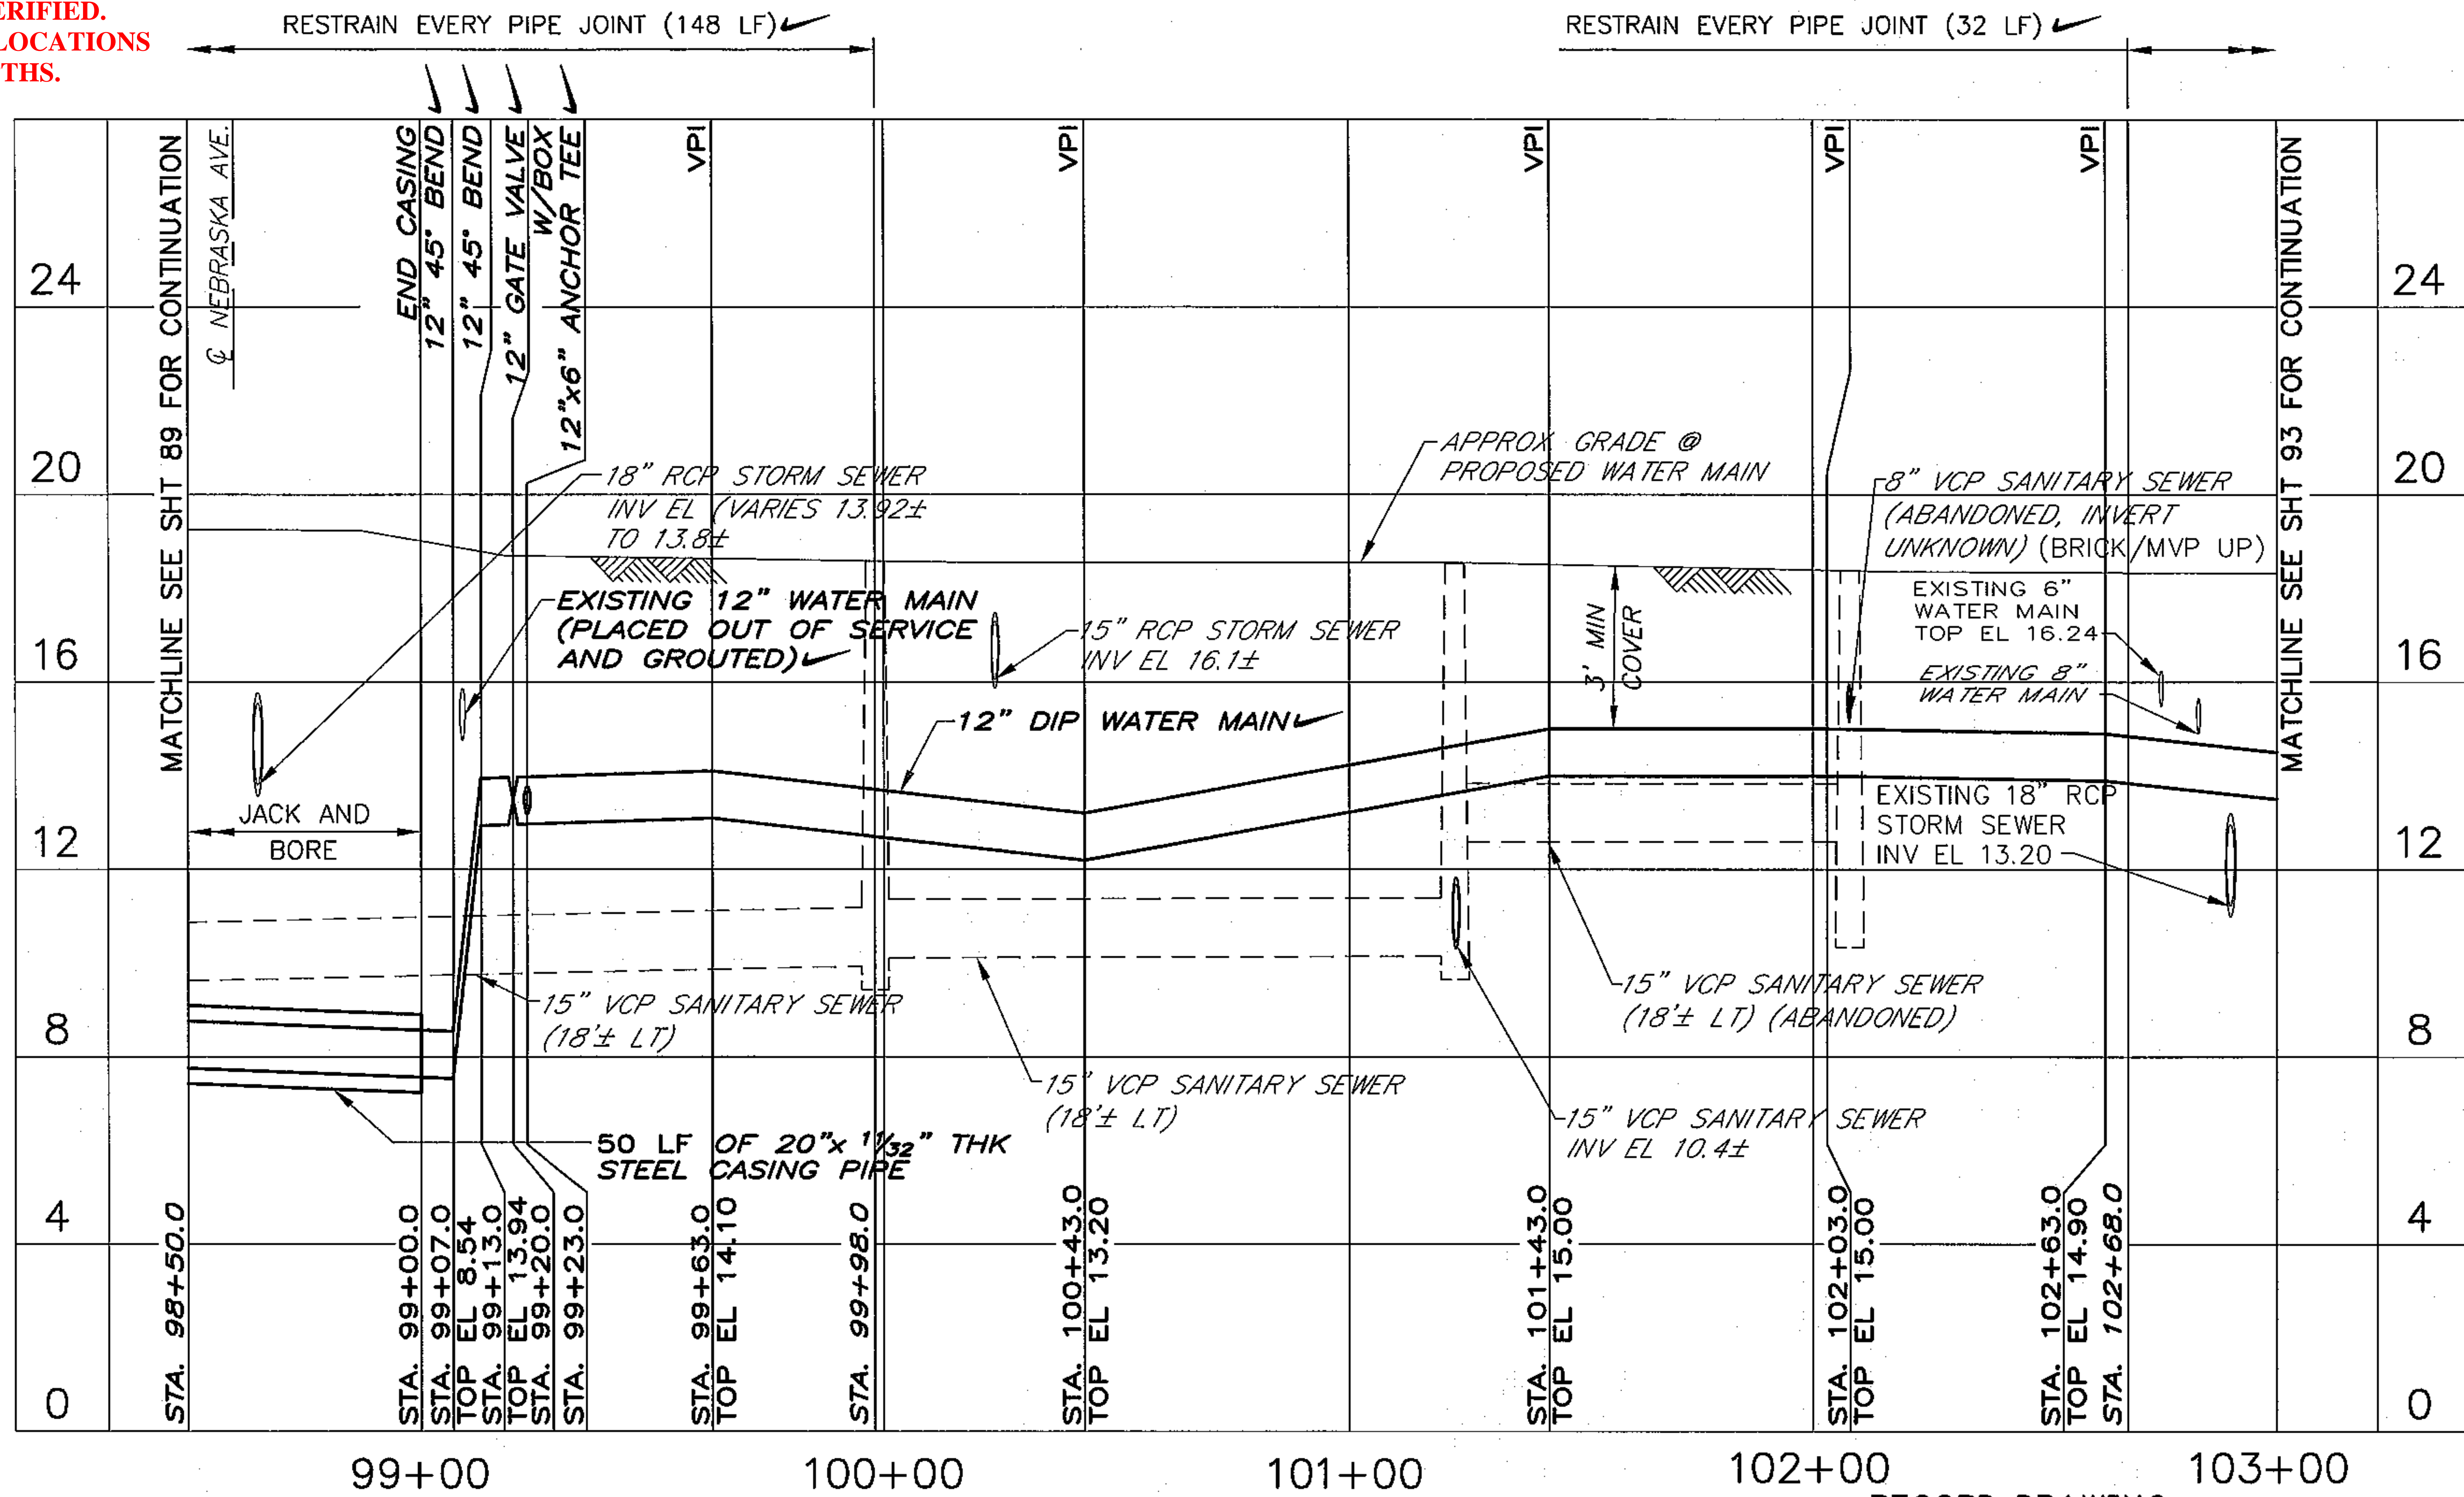

**RECORD DRAWING LEGEND**


✓ SIGNIFIES COMPLETION AS DESIGNED  
STA. 12+19.1, 7.5' RT. AS-BUILT INFORMATION (TEXT NOT SLANTED)

**PROFILE**

**RECORD DRAWING**  
THIS RECORD DRAWING IS NOT WARRANTED BUT IS BELIEVED TO REPRESENT CONDITIONS UPON COMPLETION OF CONSTRUCTION WITHIN REASONABLE TOLERANCES, BASED UPON THE INFORMATION FURNISHED TO THE ENGINEER FROM THE CONTRACTOR PERTAINING TO CHANGES MADE DURING CONSTRUCTION. STRIKE THROUGH OF THE ORIGINAL DESIGN/CALL-OUTS WERE NOT USED.



**GREELEY AND HANSEN**  
1715 N. WESTSHORE BLVD., STE. 464  
TAMPA, FLORIDA 33607  
CERTIFICATE OF AUTHORIZATION NO. 37

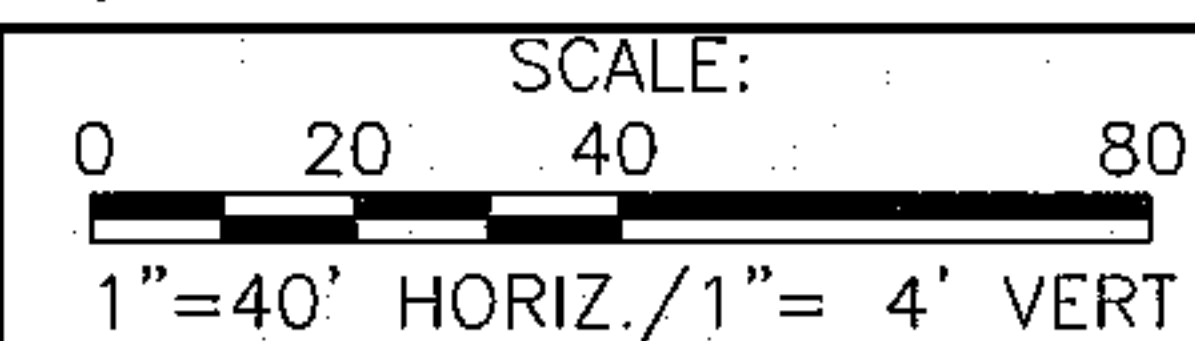

DESIGNED NAM, ML  
DRAWN GAG  
CHECKED TYW

NO.	DATE	APPD	REVISION
3	07/11	TYW	RECORD DRAWING REVISIONS

P.E. NAME: THOMAS Y. WILSON P.E. NO. 40284  
P.E. NAME: \_\_\_\_\_  
DATE: \_\_\_\_\_

CITY OF TAMPA WATER DEPARTMENT  
2008 WATER MAIN IMPROVEMENTS - DOWNTOWN PHASE C  
PROFILE  
TWIGGS STREET  
STA. 98+50.0 TO STA. 103+00.0

W.O. NO. 7042  
FILE: DTCTESH05E  
NO. 91 OF 134  
DATE JULY 2011

SHT 91, 7/20/2011 3:48:23 PM

FC84-453