



HILLSBOROUGH COUNTY SHERIFF, FLORIDA

E. TWIGGS STREET
 N. MERIDIAN AVENUE TO N. EAST STREET
 FIBER OPTIC NETWORK
AS-BUILT
 SEPTEMBER 2019





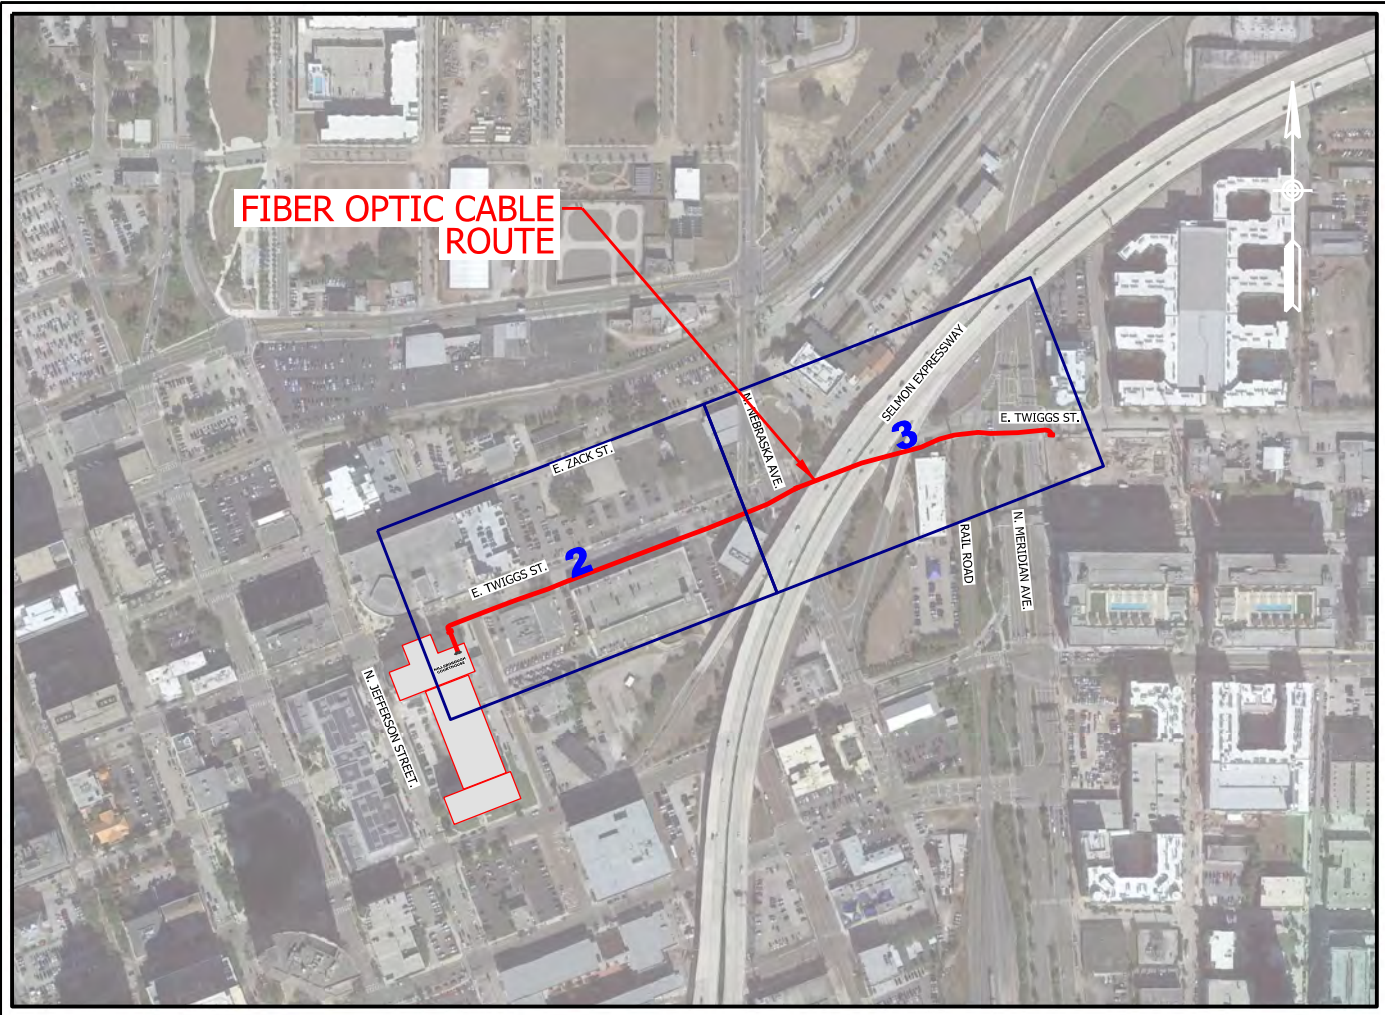

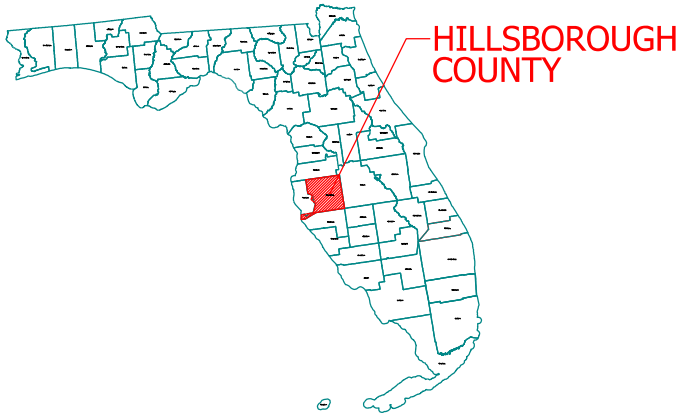INDEX OF SHEETS:
 SHEET 1 - COVER SHEET
 SHEET 2 - FIBER OPTIC ROUTE
 SHEET 3 - FIBER OPTIC ROUTE



LOCATION MAP
 SCALE : 1" = 500'



LEGEND

-  CABINET
-  SPLICE PULL BOX
-  PULL BOX
-  96 FIBER SM CABLE/CONDUIT
-  24 FIBER SM CABLE/CONDUIT
-  12 FIBER SM CABLE/CONDUIT



PCS
 PRECISION CONTRACTING SERVICES INC.
 Precision Fiber Optic Systems
 15834 Guild Court, Jupiter, FL 33458
 (561) 743-9737 Office

PROJECT NUMBER:
 18530
 DATE:
 09/16/2019
SHEET
 1

V:\Work Space\Fibertrak\Hillsborough Sheriff\18530_HCSO_Twiggs St_VHCSO_Twiggs ST_Master Model.dgn
 DRAFTED BY: JOSE ALICEA



1" = 60'

MATCH LINE - SEE SHEET 3

REVISIONS			
DESCRIPTION	CHK'D	APR'D	DATE

DESIGNED BY:

BRUCE R. BOYD, RCDD

CLIENT:
HILLSBOROUGH COUNTY SHERIFF



Precision Contracting Services, Inc.
15834 Guild Court
Jupiter, Florida 33478
(561) 743-9737 Office



PROJECT NAME AND DESCRIPTION:
HILLSBOROUGH COUNTY SHERIFFS DEPARTMENT
TWIGGS STREET,
N. MERIDIAN AVENUE TO N. EAST STREET.
FIBER OPTIC NETWORK AS-BUILT

DGN PATH: V:\Work Space\Fibertrak\Hillsborough Sheriff\18530 HCSO Twiggs St\HCSO Twiggs ST Master Model.dgn
DRAFTED BY: JOSE ALICEA

PROJECT NUMBER:
18530
DATE:
09/16/2019
SHEET
02





REVISIONS			
DESCRIPTION	CHK'D	APR'D	DATE

DESIGNED BY:
BRUCE R. BOYD, RCDD

CLIENT:
HILLSBOROUGH COUNTY SHERIFF

Precision Contracting Services, Inc.
15834 Guild Court
Jupiter, Florida 33478
(561) 743-9737 Office

PROJECT NAME AND DESCRIPTION:
**HILLSBOROUGH COUNTY SHERIFFS DEPARTMENT
TWIGGS STREET.
N. MERIDIAN AVENUE TO N. EAST STREET.
FIBER OPTIC NETWORK AS-BUILT**

DGN PATH: V:\Work Space\Fibertrak\Hillsborough Sheriff\18530 HCSO Twiggs St\HCSO Twiggs ST Master Model.dgn

DRAFTED BY: **JOSE ALICEA**

PROJECT NUMBER:
18530

DATE:
09/16/2019

SHEET
03