


HILLSBOROUGH CO, FL
CITY OF TAMPA

SEE 883-00246 SH 02 OF 02 STA 6132+44 TO ORLANDO

SEE 883-00247 SH 02 OF 02 STA 6146+20 TO TAMPA

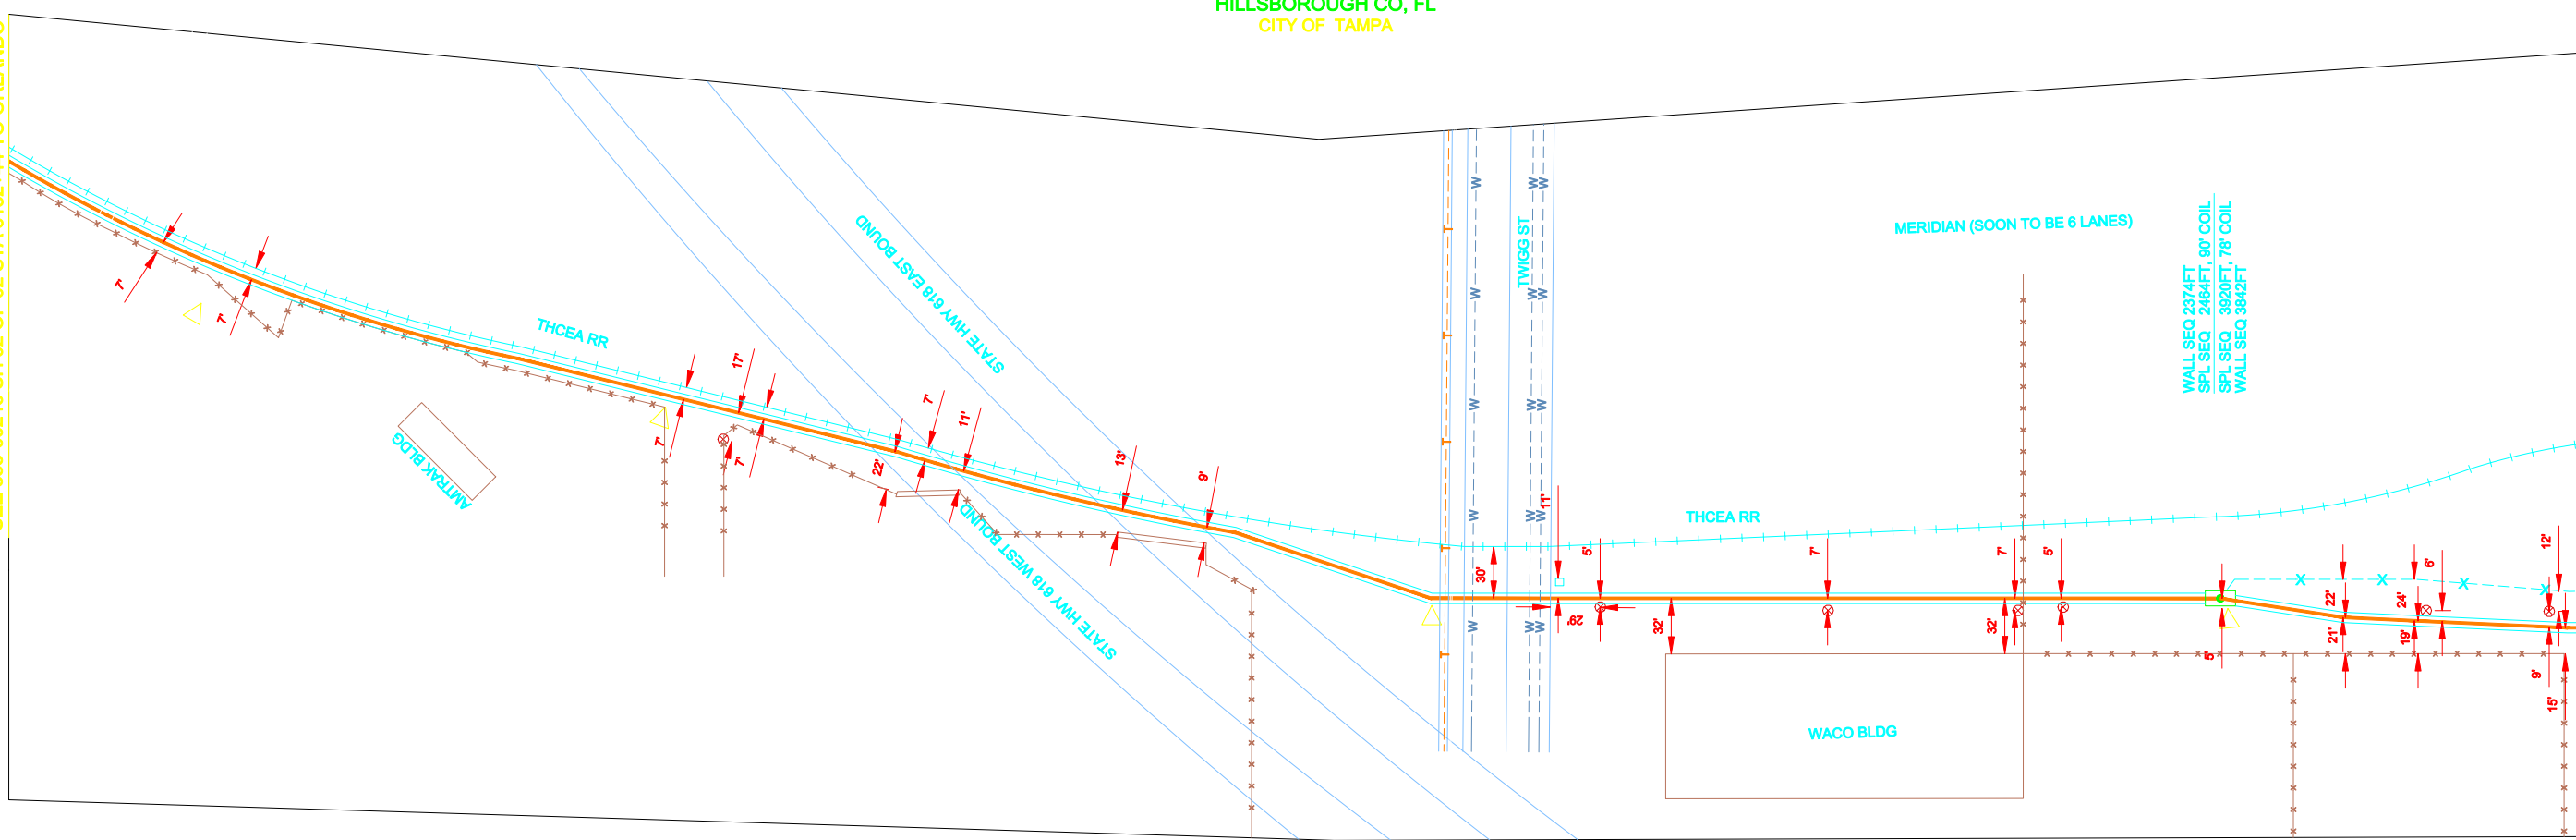

6132+88 12" IRON PIPE (48")
6132+96 1/2" IRON PIPE (48")

6133+62 PIRT FENCE, CA MKR
6134+19 PIRT FENCE

6135+24 PIRT FENCE
6135+35 PIRT FENCE

6136+35 CA MKR

6138+75 OH HIGH VOLTAGE POLE

6137+01 EDGE OF OVERPASS (WB)
6137+24 EDGE OF RR CRASHWALL
6137+51 EDGE OF OVERPASS (WB)
6137+59 EDGE OF RR CRASH WALL

6138+03 EDGE OF OVERPASS (EB)
6138+15 EDGE OF RR CRASHWALL
6138+62 EDGE OF OVERPASS (EB)
6138+67 EDGE OF RR CRASHWALL, CA MKR
6138+82 PIRT

6140+02 PL, CA MKR
6140+10 6-4" PVC VERIZON DUCT BANK
6140+12 E OF SW
6140+13 2" PVC PIPE
6140+14 1/2" COPPER PIPE
6140+21 EOP TWIGGS ST
6140+26 12" WM
6140+59 10" WM
6140+65 8" WM
6140+71 EOP TWIGGS ST
6140+76 RR X-ING LIGHTS
6141+00 OH HIGH VOLTAGE POLE
6141+36 NORTH END OF WACO BLDG

6142+32 PWR POLE

6143+42 PWR POLE

6143+45 SOUTH END OF WACO BLDG

6143+68 OH HIGH VOLTAGE POLE

6144+09 END 4" BIP, HH, SPL, BEG 4" GIP, CA MKR
6144+47 BEG 72" COVER

6144+62 FENCE

6144+65 30" CONC PIPE, 30" COVER

6144+76 END 72" COVER

6144+81 PROP CORNER

6145+23 PROP CORNER

6145+28 OH HIGH WIRE POLE

6145+77 BEG 52" COVER, GUY WIRE ANCHOR, END 48" COVER

6145+80 GUY WIRE ANCHOR

6145+97 OH HIGH WIRE POLE

6146+14 BM 69 ELEVY 16.62

1253'
REEL # UNK
CORNING CABLE CORNING GLASS
PLACED 2003

1165' - 4" BIP
E/W 2 - 3 X 3" MAXCELL

289'
REEL # UNK
CORNING CABLE CORNING GLASS
PLACED 2004

211' - 4" GIP
E/W - 3 X 3" MAXCELL

XREF: EXREF246-00-000-883-00246-01

REVISIONS			
ISSUE	DESCRIPTION	DRAFTER RELEASE NUMBER	ENGINEER RELEASE NUMBER
04	AS-BUILT CHANGES (03-31-04) PLACED 1424' OF FOC, 1264' - 4" GIP, 2528' OF 3X3" MAXCELL BETWEEN STA 6144+09 TO 6156+62, 1 SPL. J425C501 - 085057-2004	04-12-2004 JF	03-31-04 ST

Sprint Proprietary Information: Restricted



SPRINT DOES NOT WARRANT OR GUARANTEE IN ANY MANNER THE ACCURACY OF THIS MAP. ANY INTENDED EXCAVATION REQUIRES NOTIFICATION OF THE LOCAL "ONE CALL CENTER" OR CALL SPRINT'S CALL-BEFORE-YOU-DIG CENTER AT 1-800-521-0579, AT LEAST 48 HOURS PRIOR TO COMMENCING ACTIVITY.

NORTH	OLD DRAWING NUMBER
WBS:	PRINT NO:
ENG. CO:	APPD DATE:

PRINTED SHEET SIZE / DRAWING SCALE
11" x 17" (B) 1" = 100'
22" x 34" (D) 1" = 50'

RELEASE DATE: ISSUE NUMBER:
04

FIBER OPTIC ROUTE RECORD DRAWING
CABLE ROUTE DETAIL
ORLANDO, FL - TAMPA, FL

SHEET 01 OF 03 NTWRK246-00-000-883-00247