DRAWING ACCURACY WAS NOT VERIFIED. FIELD VERIFY LOCATIONS AND DEPTHS.

SEC. 19-T29S-R19E

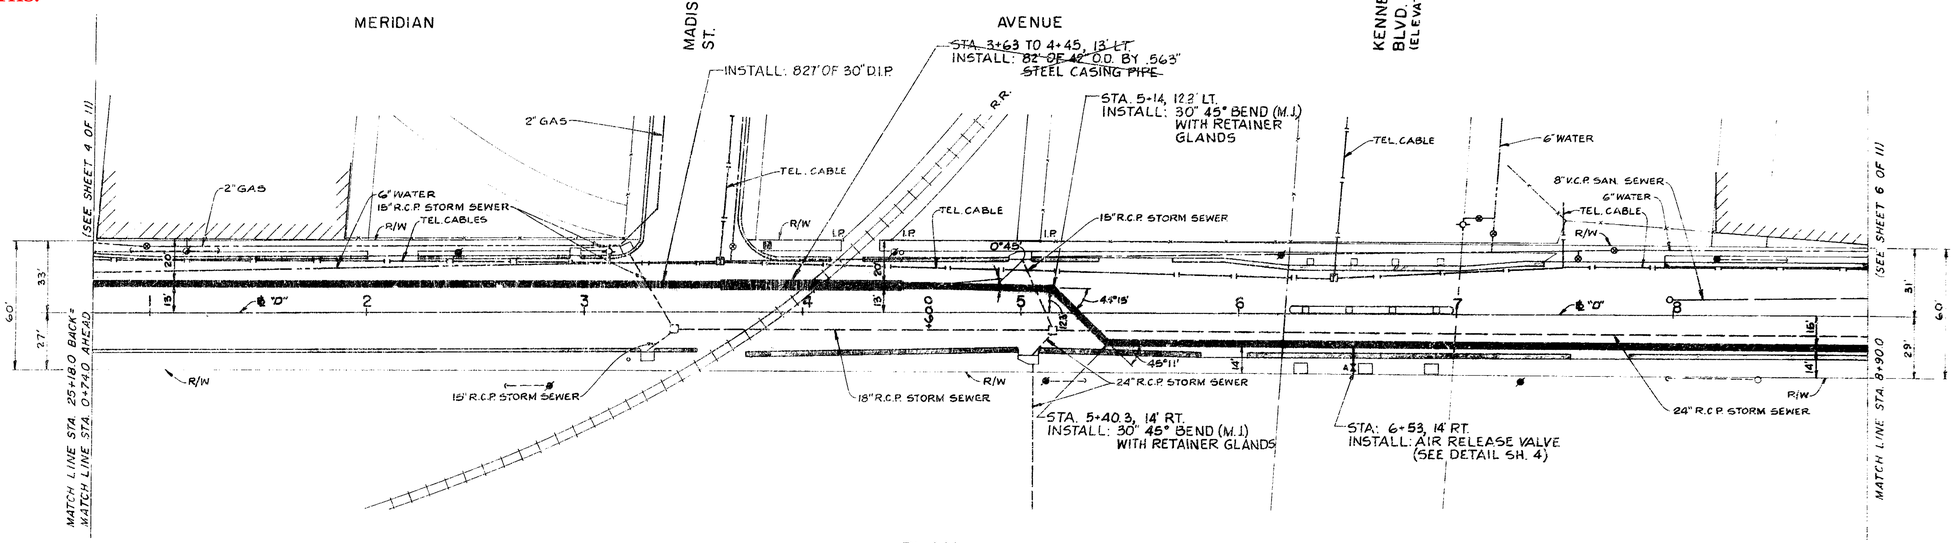

PLAN

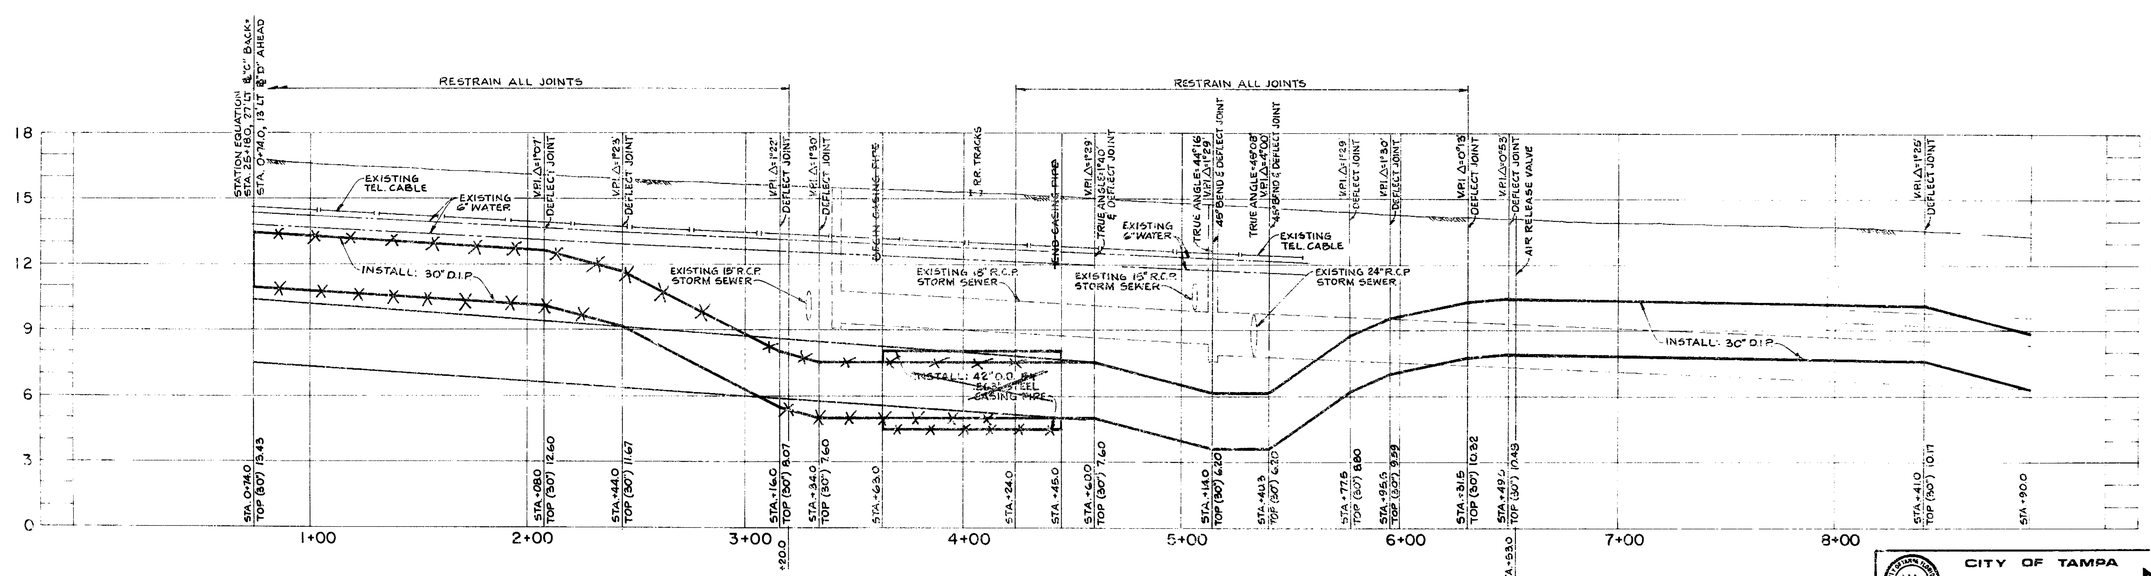

PROFILE

SCALE: 30 0 30 60 FT. HORIZ. 1" = 30'; 3 0 3 6 FT. VERT. 1" = 3'

LFC 3-2-87
JAE 3-11-87

No.	By	Date	Revision

GREELEY AND HANSEN ENGINEERS
4350 WEST CYPRESS STREET
TAMPA, FLORIDA 33607

ARTHUR H. ABEL, CERTIFICATE NO. 9752, STATE OF FLORIDA, REGISTERED ENGINEER

CITY OF TAMPA
WATER DEPARTMENT
ENGINEERING DIVISION

DOWNTOWN TRANSMISSION MAIN

MERIDIAN AVENUE - STA. 0+74 TO STA. 8+90

Approved		Date	
Des: SBF	W.O. 9891		File DOWNTOWN T.M.
Dwn: AA	DRAWING NUMBER 86-053		FILE NUMBER D4-2-23
Ckd: RSH, TLW	Sheet 5 of 11 Sheets		