NOTES:
1. SEE SHEET 88 FOR PLAN VIEW FROM STATION 51+16.0 TO STATION 51+81.0
2. ELEVATION OF GAS MAIN UNKNOWN. VERIFY PRIOR TO CONSTRUCTION.

DRAWING ACCURACY WAS NOT VERIFIED. FIELD VERIFY LOCATIONS AND DEPTHS.

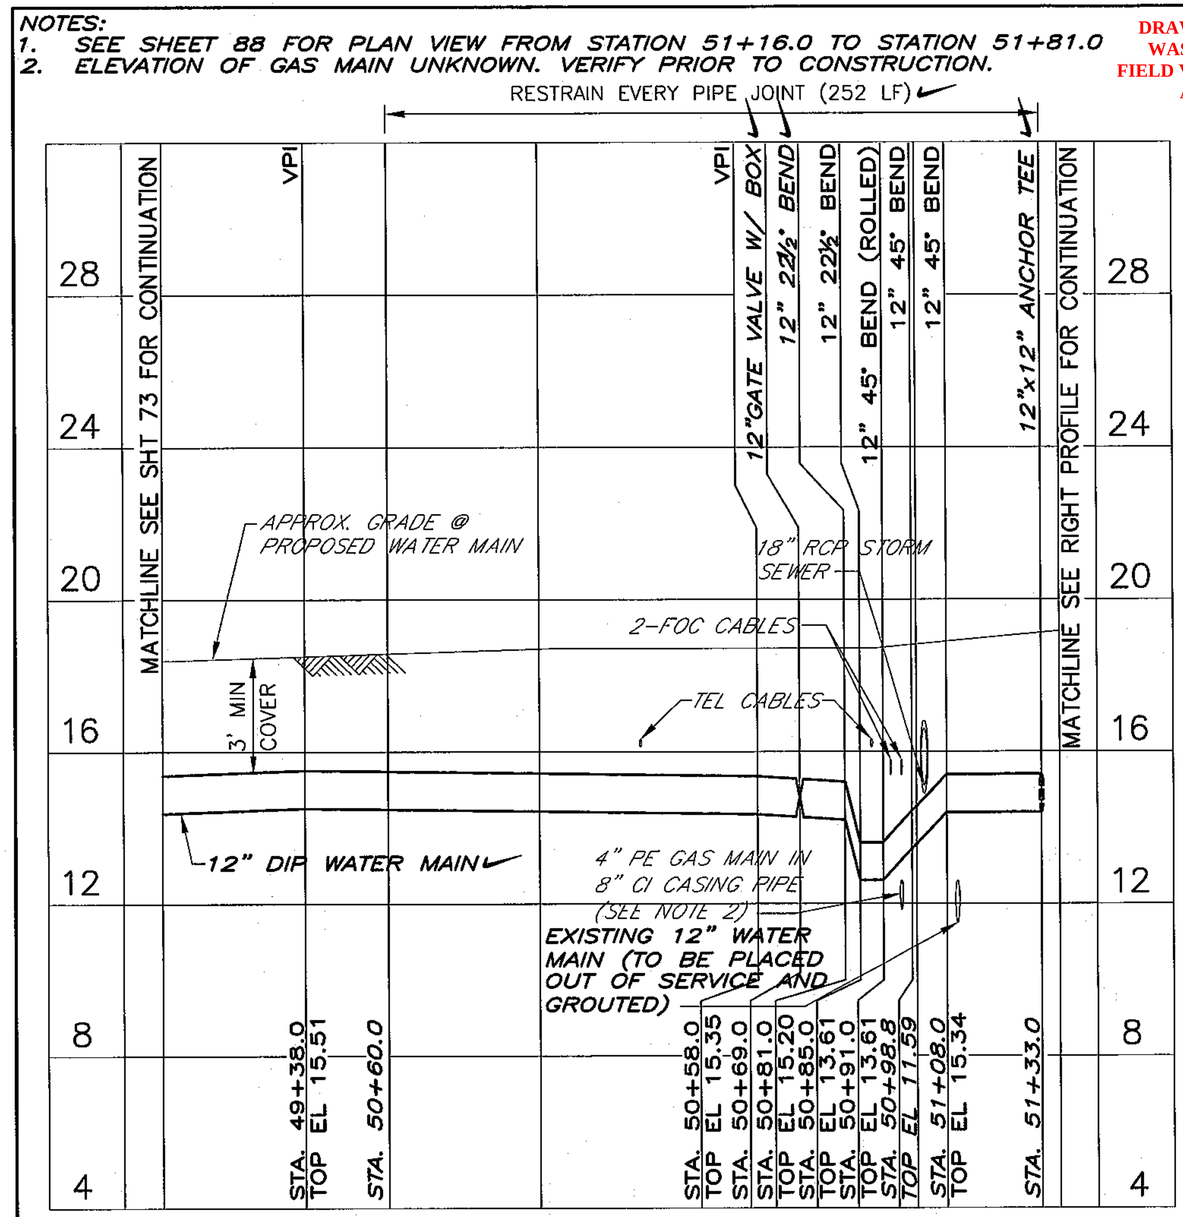

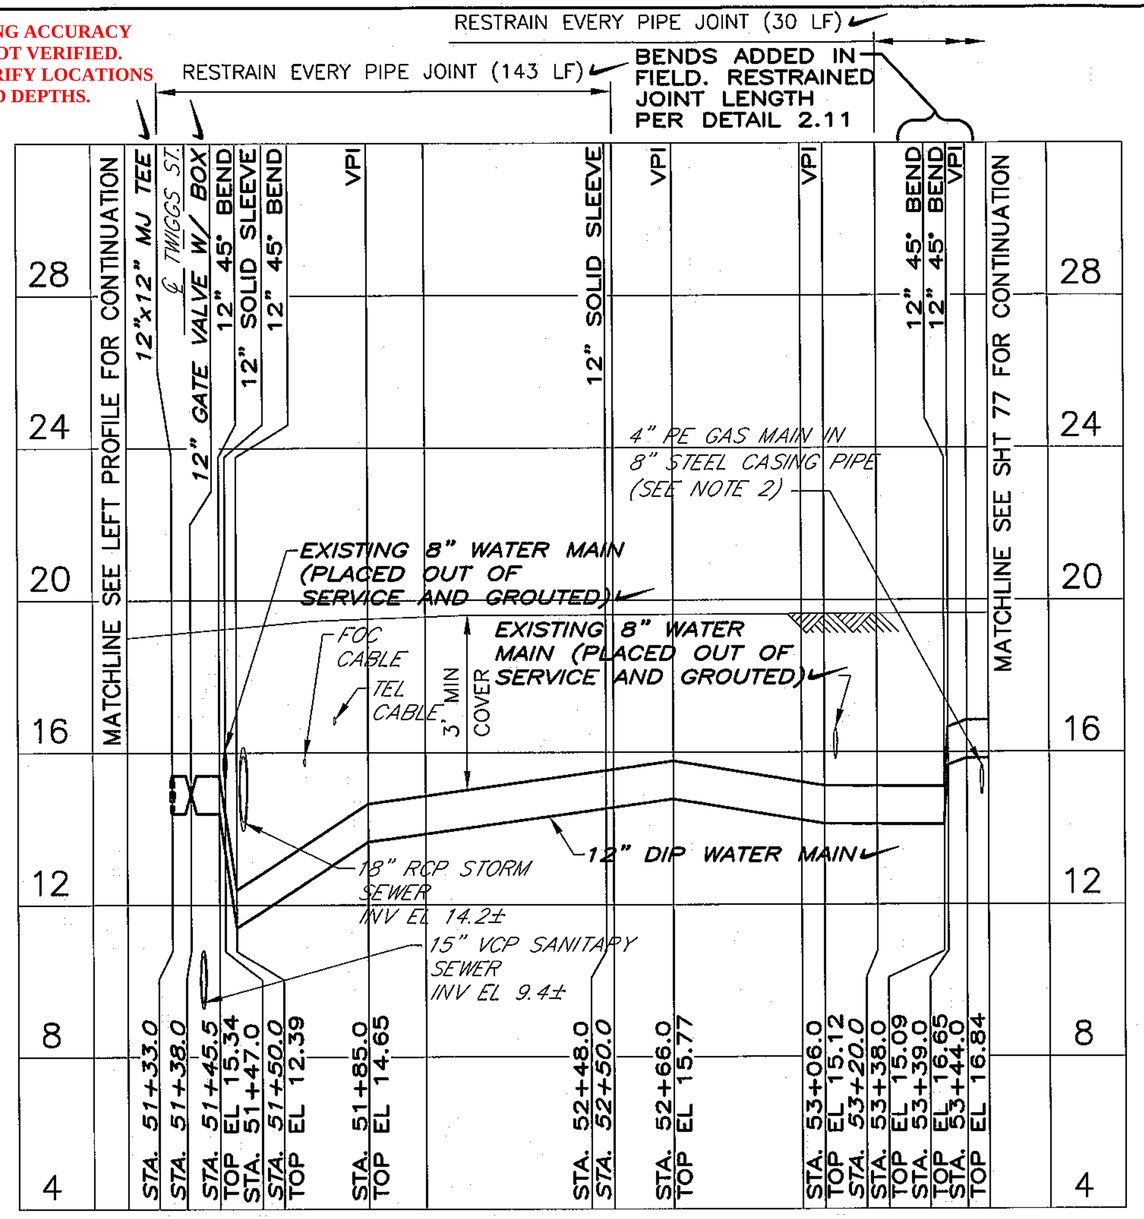

PROFILE

RECORD DRAWING

THIS RECORD DRAWING IS NOT WARRANTED BUT IS BELIEVED TO REPRESENT CONDITIONS UPON COMPLETION OF CONSTRUCTION WITHIN REASONABLE TOLERANCES, BASED UPON THE INFORMATION FURNISHED TO THE ENGINEER FROM THE CONTRACTOR PERTAINING TO CHANGES MADE DURING CONSTRUCTION. STRIKE THROUGHS OF THE ORIGINAL DESIGN/CALL-OUTS WERE NOT USED. SEE RECORD DRAWING LEGEND ON THIS SHEET.

RECORD DRAWING LEGEND

✓ SIGNIFIES COMPLETION AS DESIGNED

STA. 12+19.1, 7.5' RT. AS-BUILT INFORMATION (TEXT NOT SLANTED)

CH2MHILL

GREELEY AND HANSEN
1715 N. WESTSHORE BLVD., STE. 464
TAMPA, FLORIDA 33607
CERTIFICATE OF AUTHORIZATION NO. 37

SCALE: 0 20 40 80
1"=40' HORIZ./1"= 4' VERT

DESIGNED	NAM, ML
DRAWN	GAG
CHECKED	TYW

NO.	DATE	APPD	RECORD DRAWING REVISIONS
3	07/11	TYW	REVISION

P.E. NAME: THOMAS Y. WILSON P.E. NO. 40284

P.E. NAME: _____

DATE: _____

UCAP
UTILITY CAPITAL IMPROVEMENT PROJECTS

CITY OF TAMPA WATER DEPARTMENT
2008 WATER MAIN IMPROVEMENTS – DOWNTOWN PHASE C

PROFILE
NEBRASKA AVENUE

STA. 49+00.0 TO STA. 53+50.0

W.O. NO. 7042
FILE: DTCTESH05
NO. 75 OF 134
DATE JULY 2011

FC84-436

SHT 75, 7/27/2011 2:11:51 PM